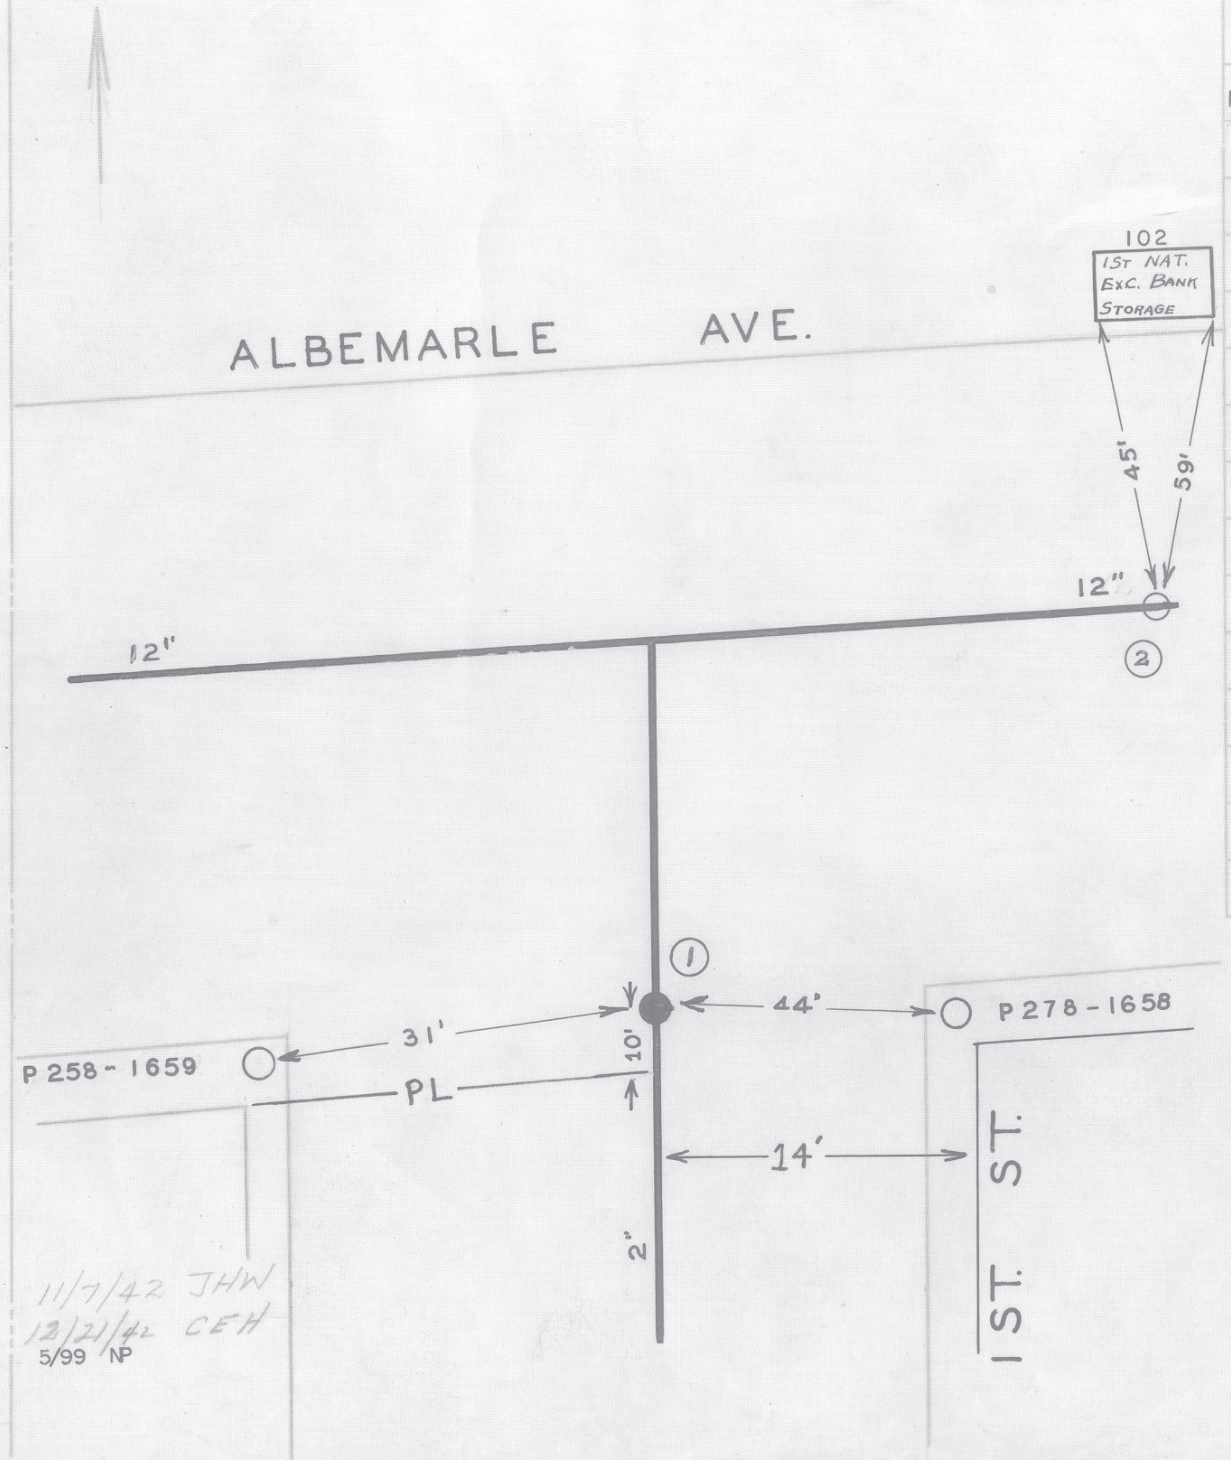

DATE	NO.	SIZE	MAKE	OPEN	TURNS
1921	1	2"		R	7
	2	1"	PITOT STA.		
	1	10'N	SPL		
	2	60'E	E.P.L.		

CITY OF ROANOKE—WATER DEP'T

VALVE DIAGRAM

ALBEMARLE AVE. & 1ST. ST.

SEC. MAP 402 S.E.

DATE PAGE NO. S.E.53