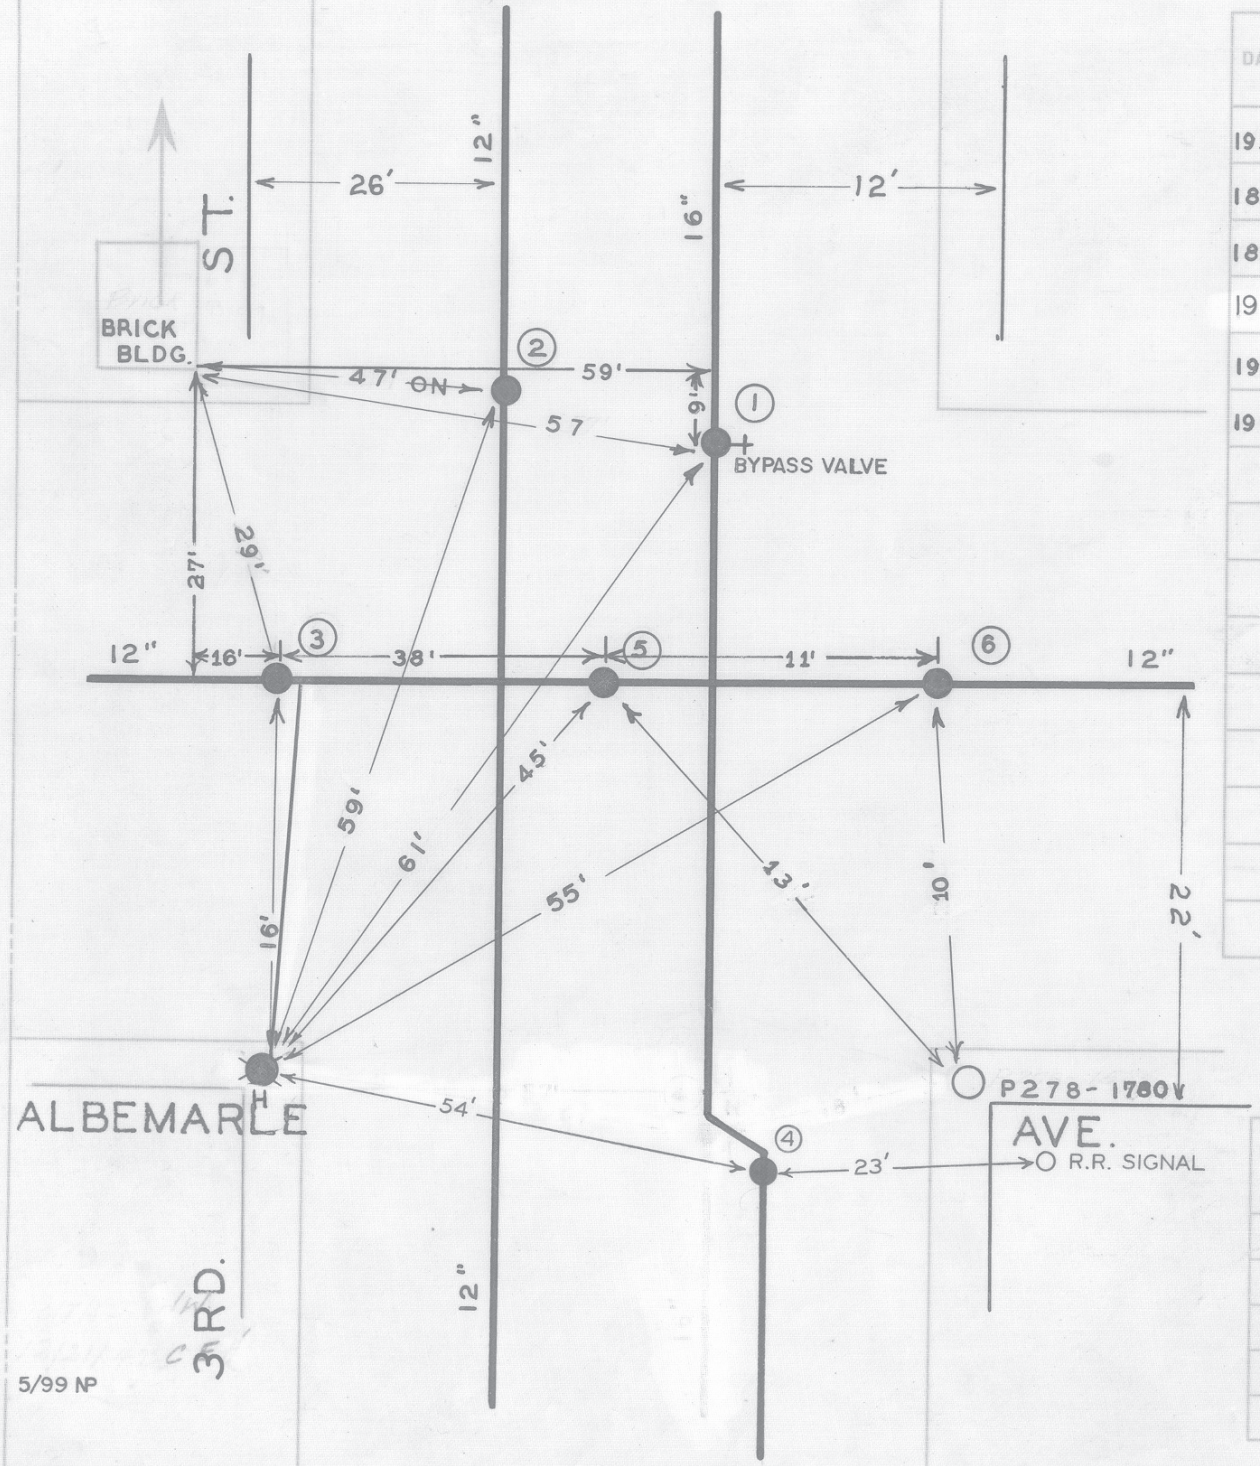

DATE	NO.	SIZE	MAKE	OPEN	TURNS
1923	1	16"		R	107
1889	2	12"		R	41
1890	3	12"		R	39
1972	4	16"	MUELLER	R	
1923	5	12"		R	25
1913	6	12"		R	38
	1	9-S	NPL		
	2	0	NPL		
	3	0	WPL		
	5	11-W	EPL		
	6	0	EPL		

CITY OF ROANOKE—WATER DEP'T

VALVE DIAGRAM

ALBEMARLE AVE. & 3RD. ST.

SEC. MAP 402 S.E.

DATE PAGE NO. S.E. 51