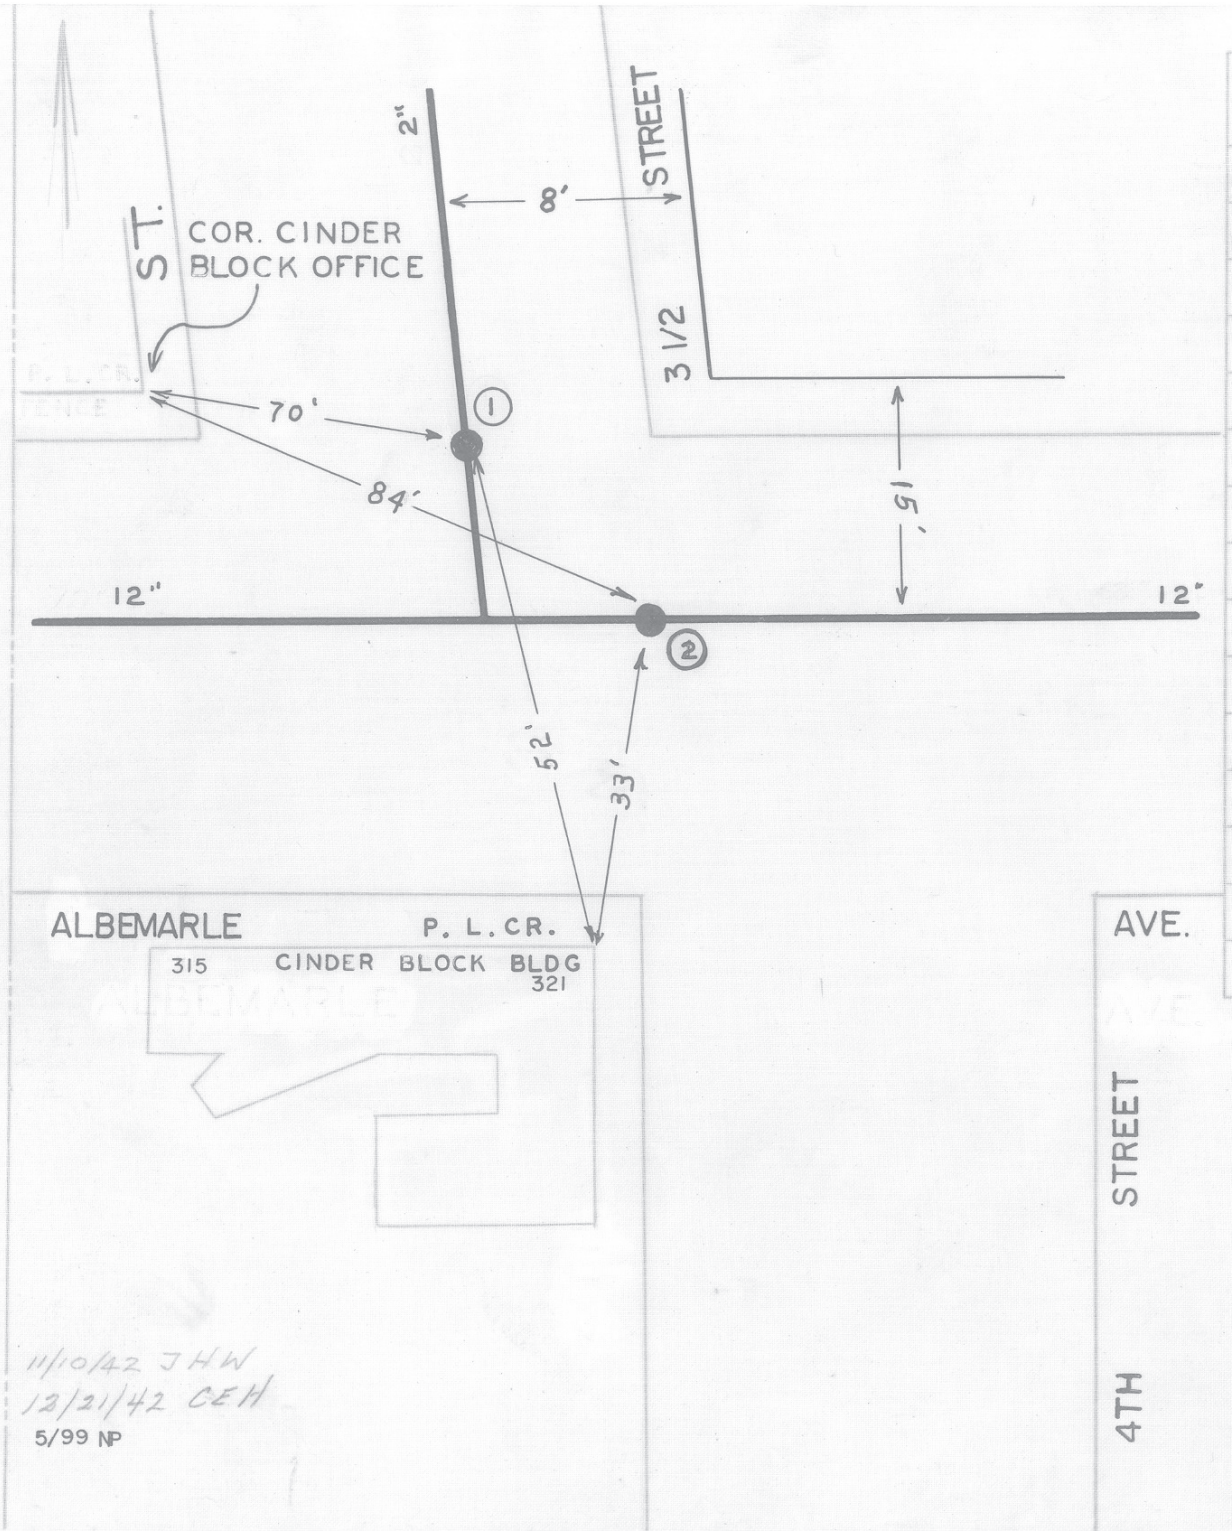

DATE	NO.	SIZE	MAKE	OPEN	TURNS
1927	1	2"		R	8
1925	2	12"		R	38
	1	0	NPL		
	2	0	EPL		

11/10/42 JHW
12/21/42 CEH
5/99 NP

CITY OF ROANOKE—WATER DEP'T
VALVE DIAGRAM

ALBEMARLE AVE. & 4TH. ST.

SEC. MAP 402 S. E.

DATE PAGE NO. S.E.48