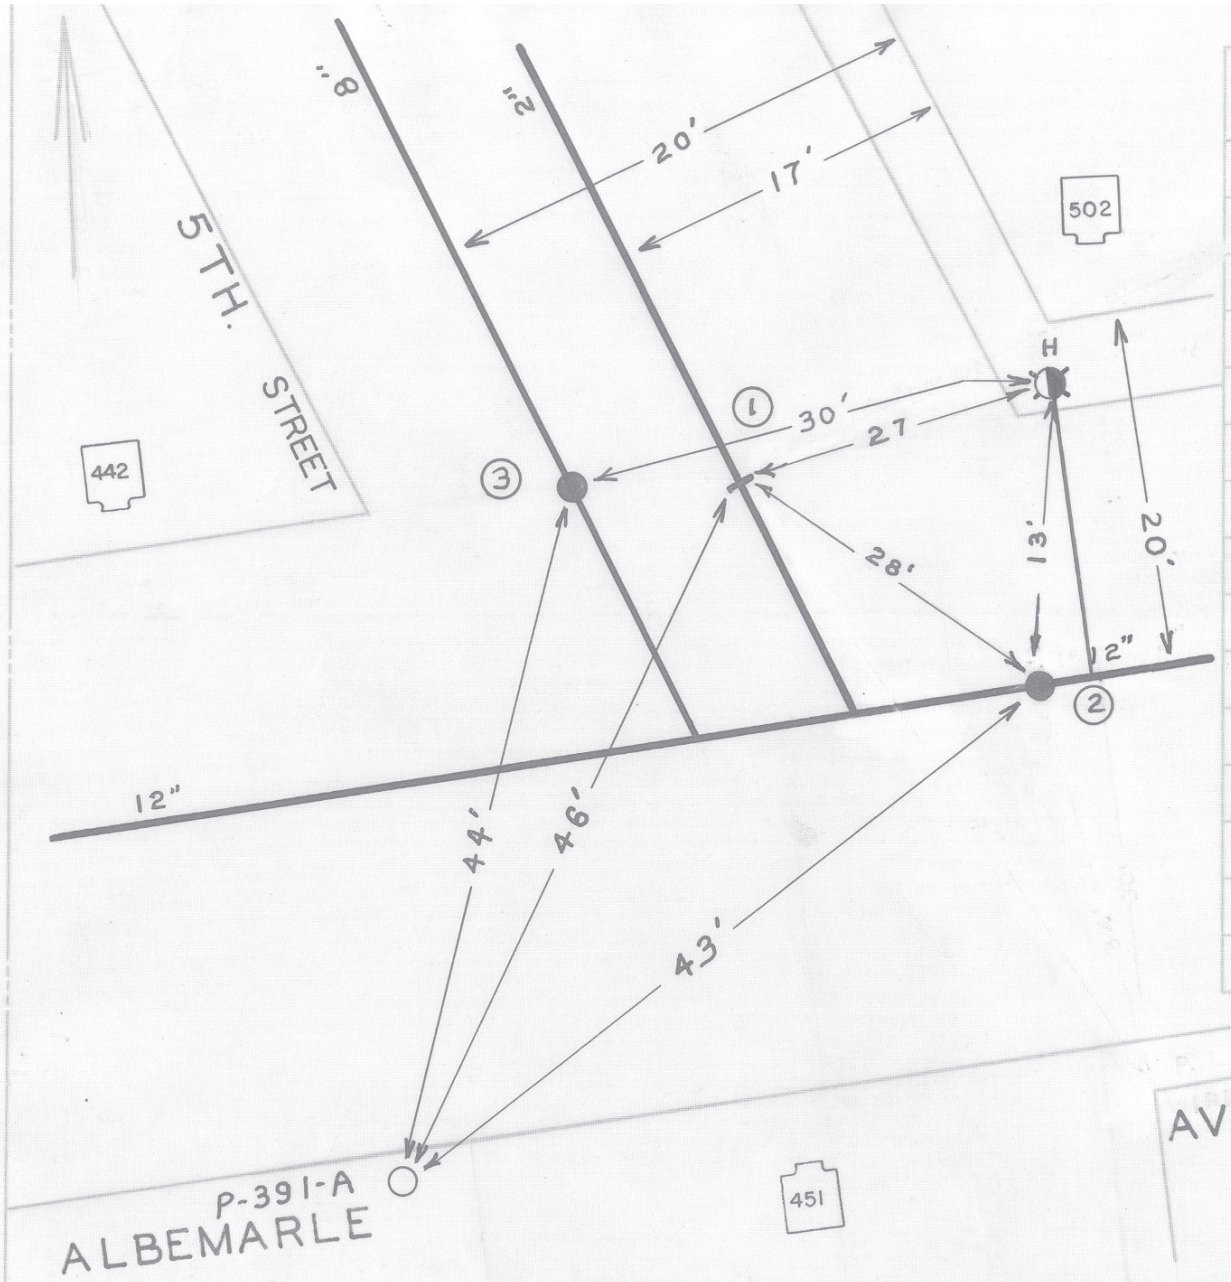

DATE	NO.	SIZE	MAKE	OPEN	TURNS
1925	1	2"		L	8
1925	2	12"		R	38
1953	3	8"			
	1	0	NPL		
	2	7'-W	EPL		
	3	0	NPL		

11/10/42 J.H.W.
12/21/42 C.E.H.
5/99 NP

CITY OF ROANOKE—WATER DEP'T
VALVE DIAGRAM

ALBEMARLE AVE. & 5TH. ST.

SEC. MAP 402 S.E.

DATE PAGE NO. S.E.49