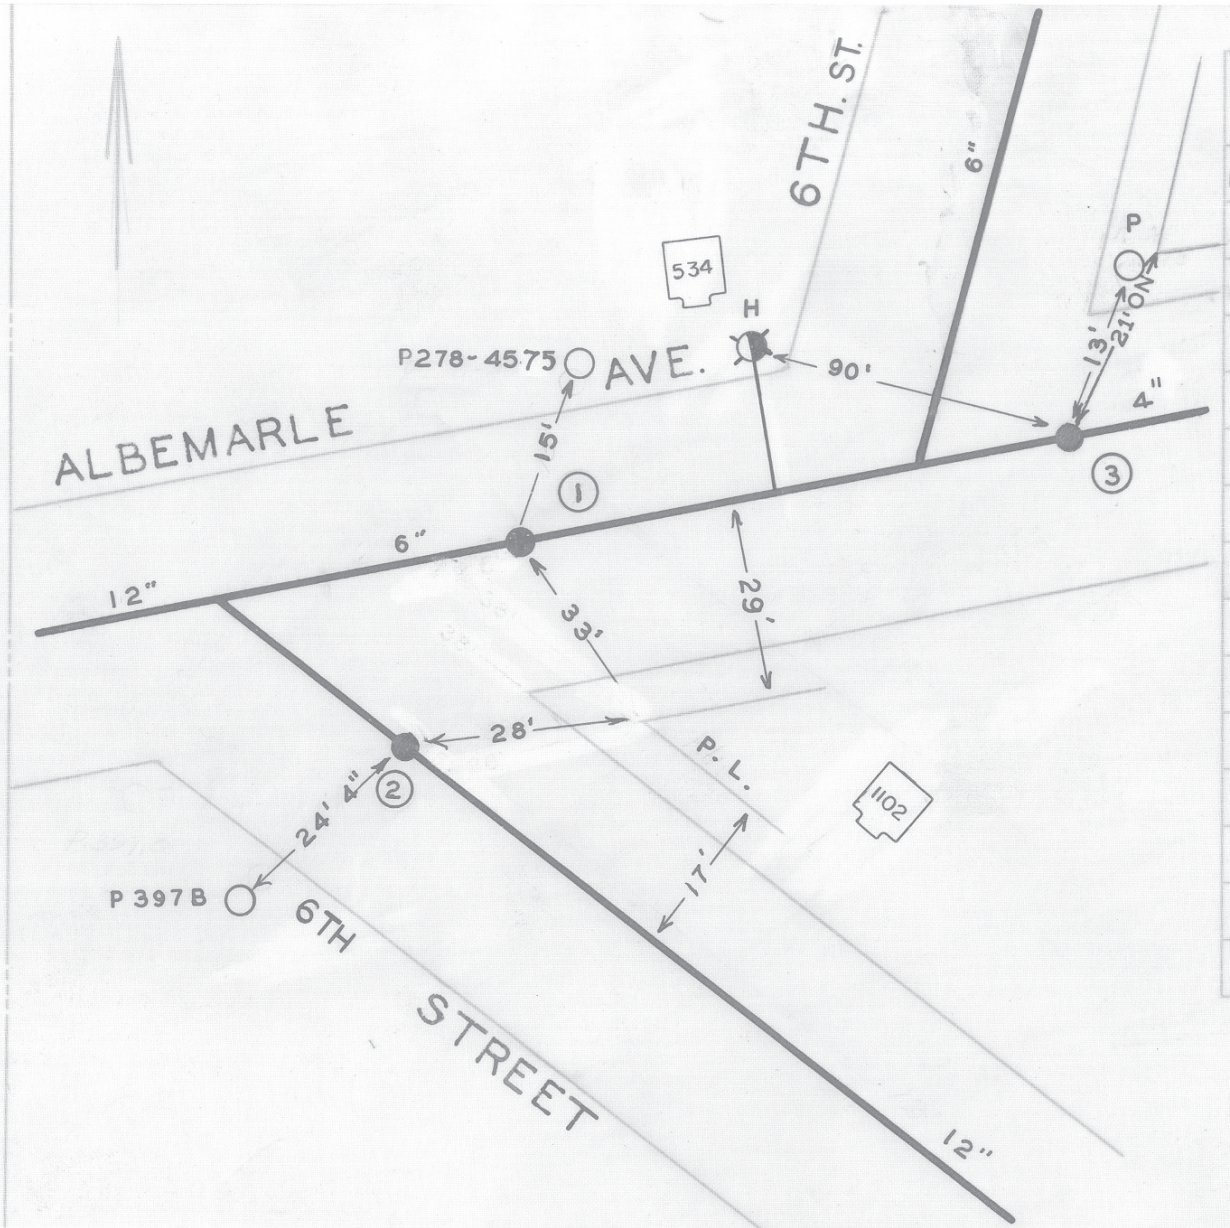

DATE	NO.	SIZE	MAKE	OPEN	TURNS
1925	1	6"		R	20
1925	2	12"		R	38
1893	3	4"		R	15
	1	6'-E	EPL		
	2	5'-N	SPL		
	3	0	EPL		

11/10/42. JHW.
12/21/42 CEH
5/99 NP

CITY OF ROANOKE—WATER DEP'T
VALVE DIAGRAM
ALBEMARLE AVE. & 6TH. ST.

SEC. MAP 402 S.E.
DATE PAGE NO. S.E. 46