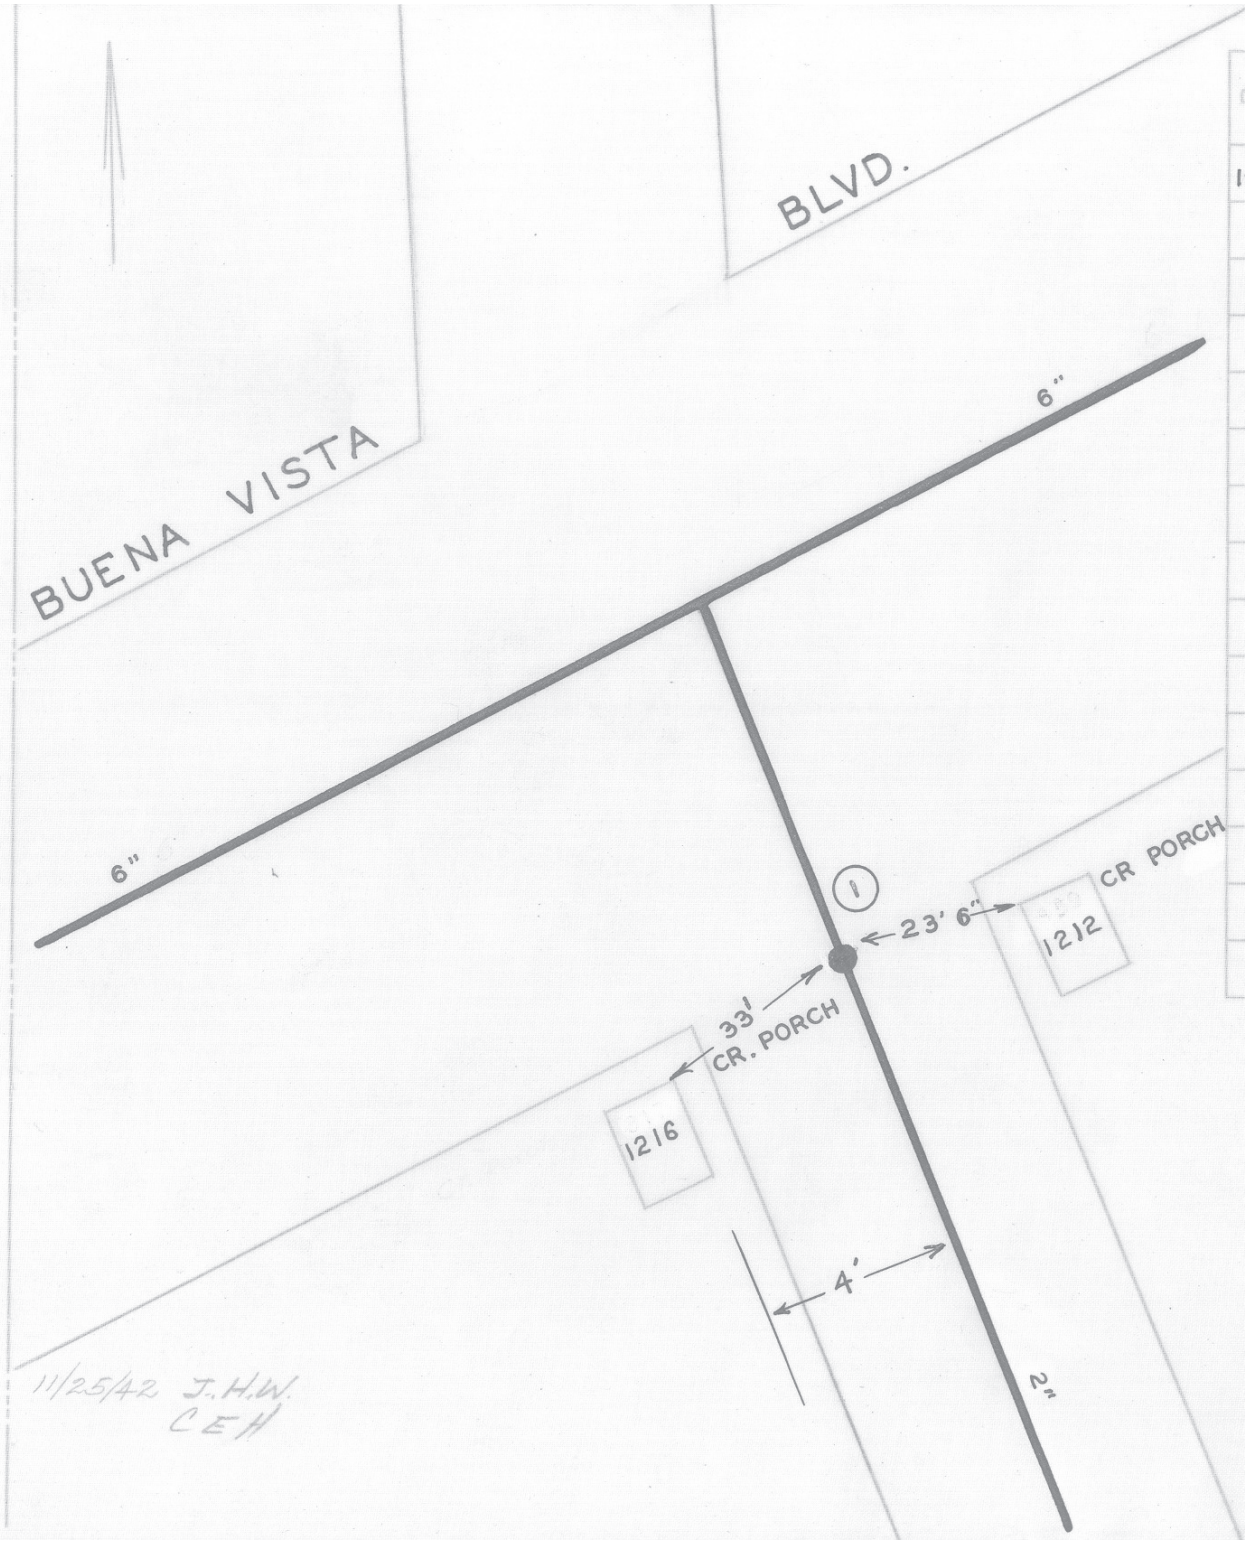

DATE	NO.	SIZE	MAKE	OPEN	TURNS
1921	1	2"		R	7
	1	12'-N	SPL		

CITY OF ROANOKE—WATER DEP'T

VALVE DIAGRAM

ALLEY W. OF 9TH. ST. FROM BUENA VISTA. BLVD. BETWEEN 817 & 839

SEC. MAP 414

DATE PAGE NO. S.E.178