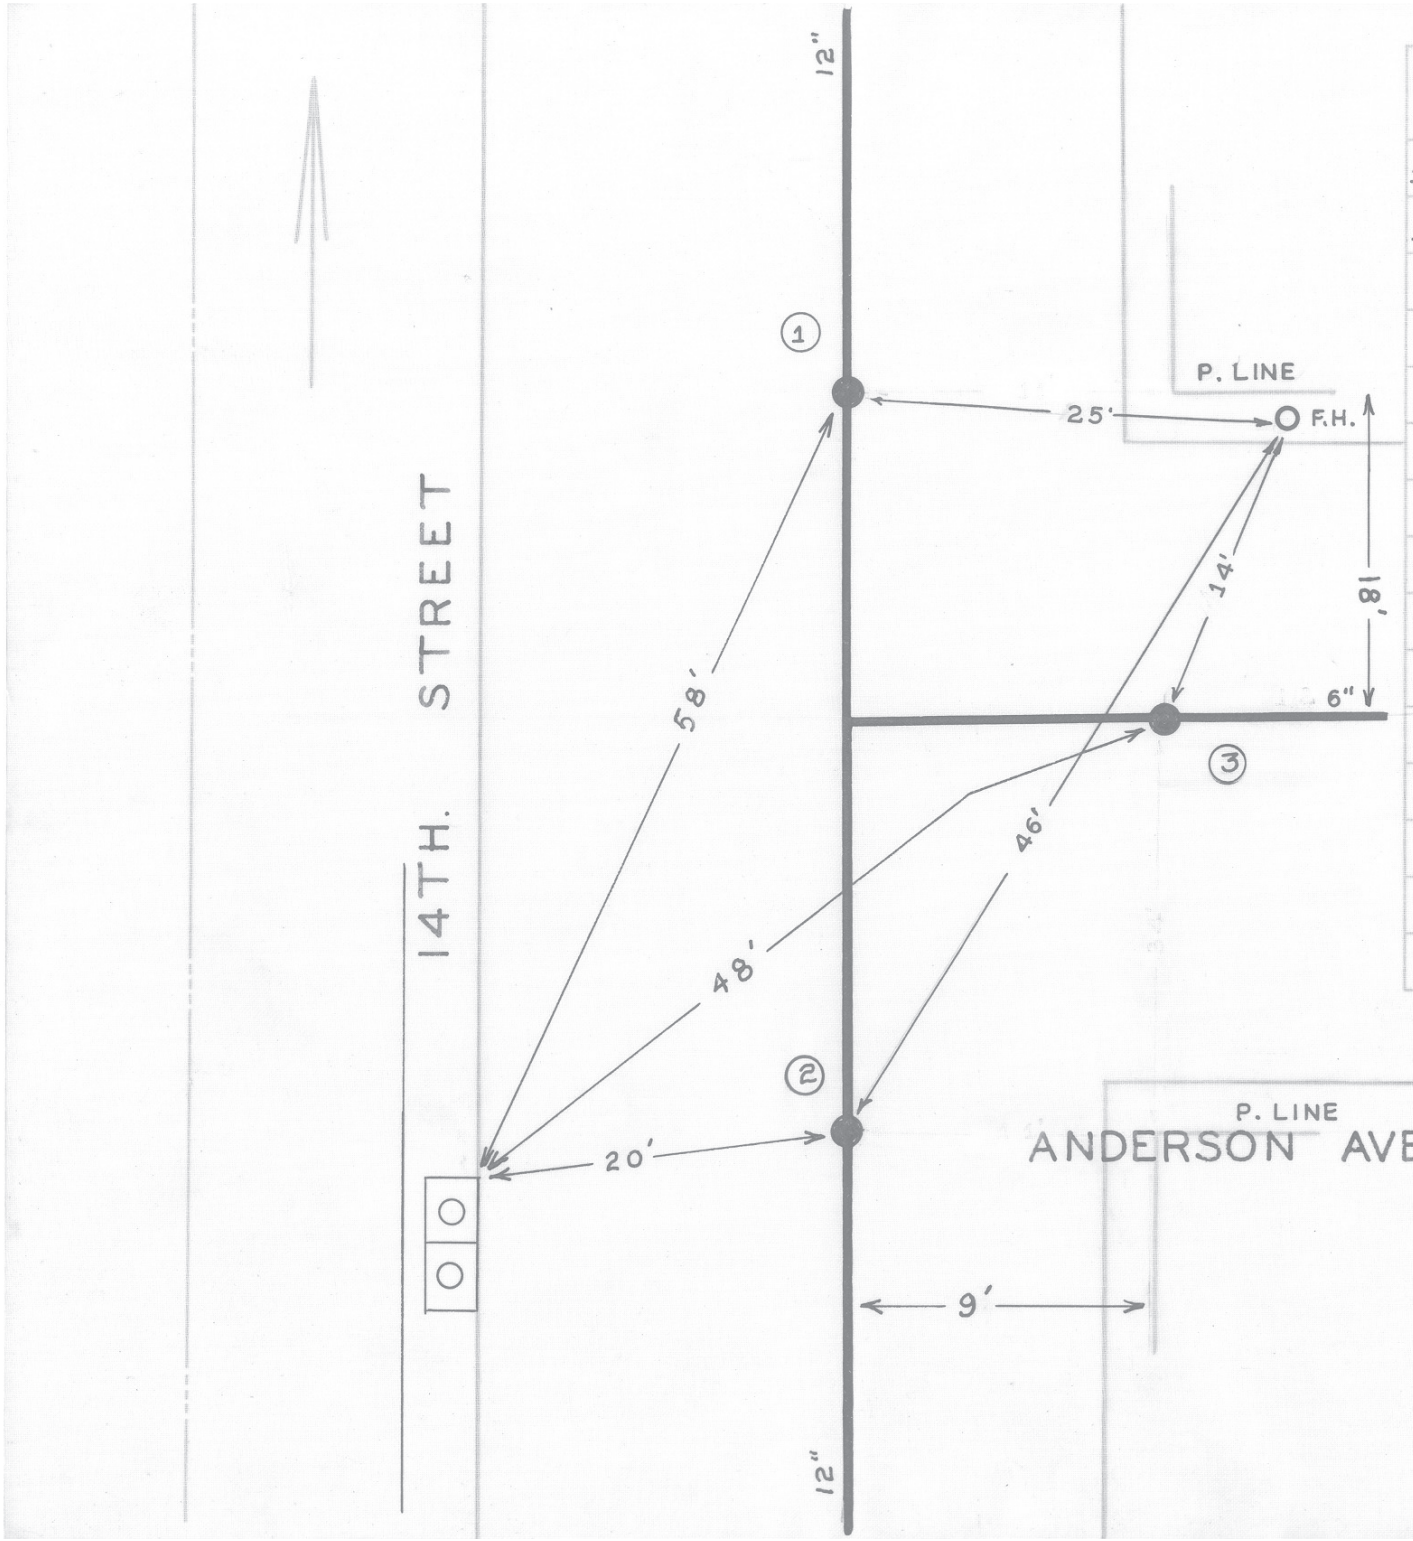

DATE	NO.	SIZE	MAKE	OPEN	TURNS
1951	1	12"	DARLING	R	39
1951	2	12"	DARLING	R	39
1951	3	6"	DARLING	R	21
	1	0	NPL		
	2	3'-E	EPL		
	3	2'-N	SPL		

CITY OF ROANOKE—WATER DEP'T

VALVE DIAGRAM

ANDERSON AVENUE &

14TH. STREET S.E.

SEC. MAP 422

DATE 2/28/51 PAGE NO. S.E.220