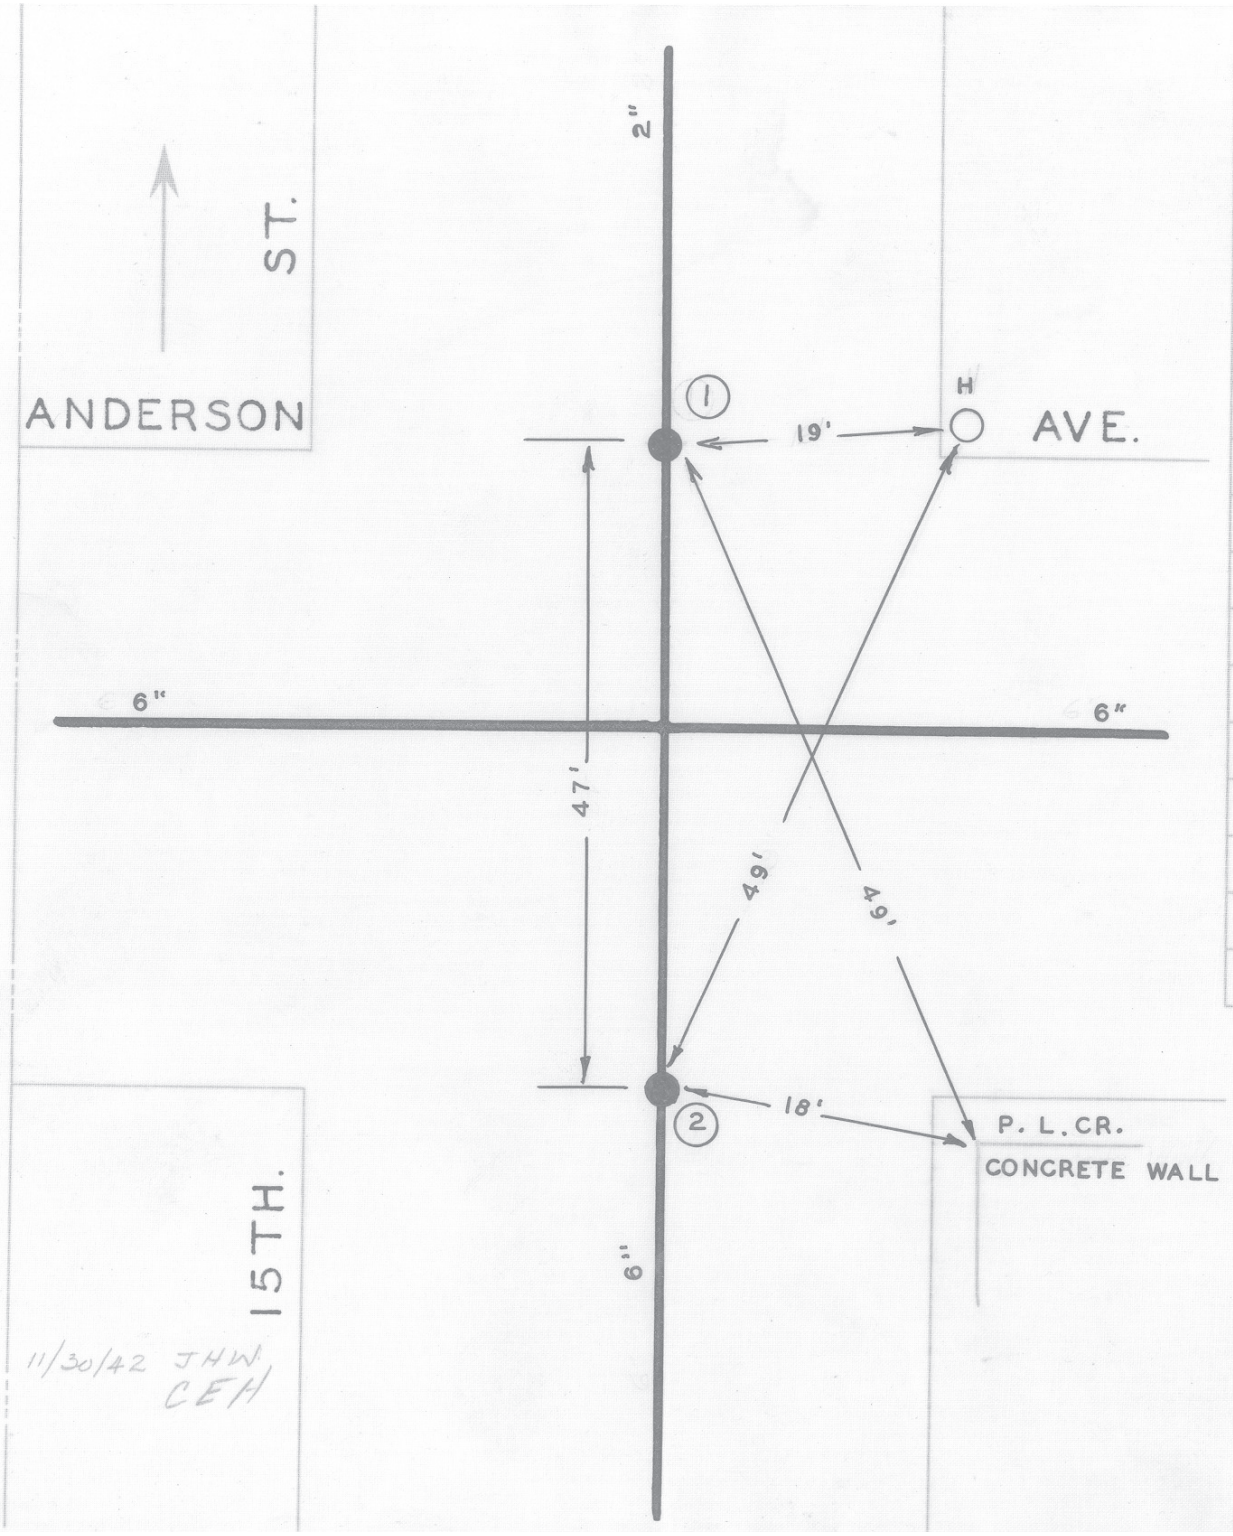

DATE	NO.	SIZE	MAKE	OPEN	TURNS
1930	1	2"		L	10
1929	2	6"		R	20
	1	0	NPL		
	2	0	SPL		

CITY OF ROANOKE—WATER DEP'T

VALVE DIAGRAM

ANDERSON AVE. & 15TH. ST. S. E.

SEC. MAP 422

DATE

PAGE NO. S.E.222