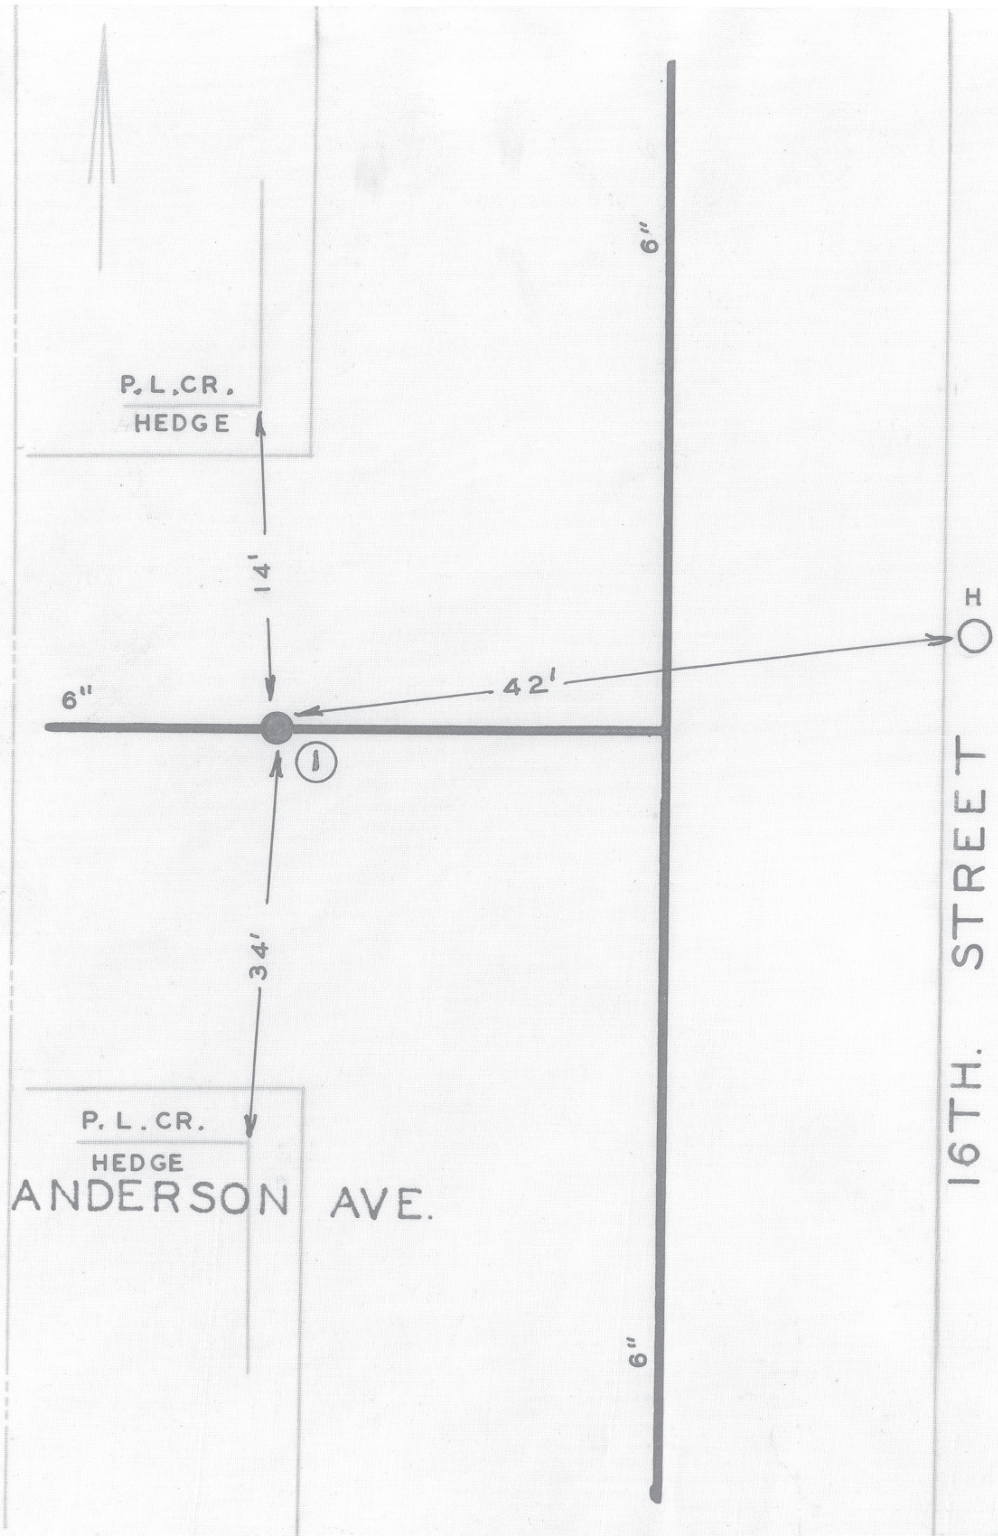


| DATE | NO. | SIZE | MAKE | OPEN | TURNS |
|---|---|---|---|---|---|
| 1929 | 1 | 6" | | R | 20 |
| | | | | | |
| | | | | | |
| | 1 | 0 | WPL | | |
| | | | | | |
| | | | | | |

CEH

CITY OF ROANOKE—WATER DEP'T
VALVE DIAGRAM

ANDERSON AVE. & 16TH. ST. S.E.

SEC. MAP 422

DATE PAGE NO. S.E.223