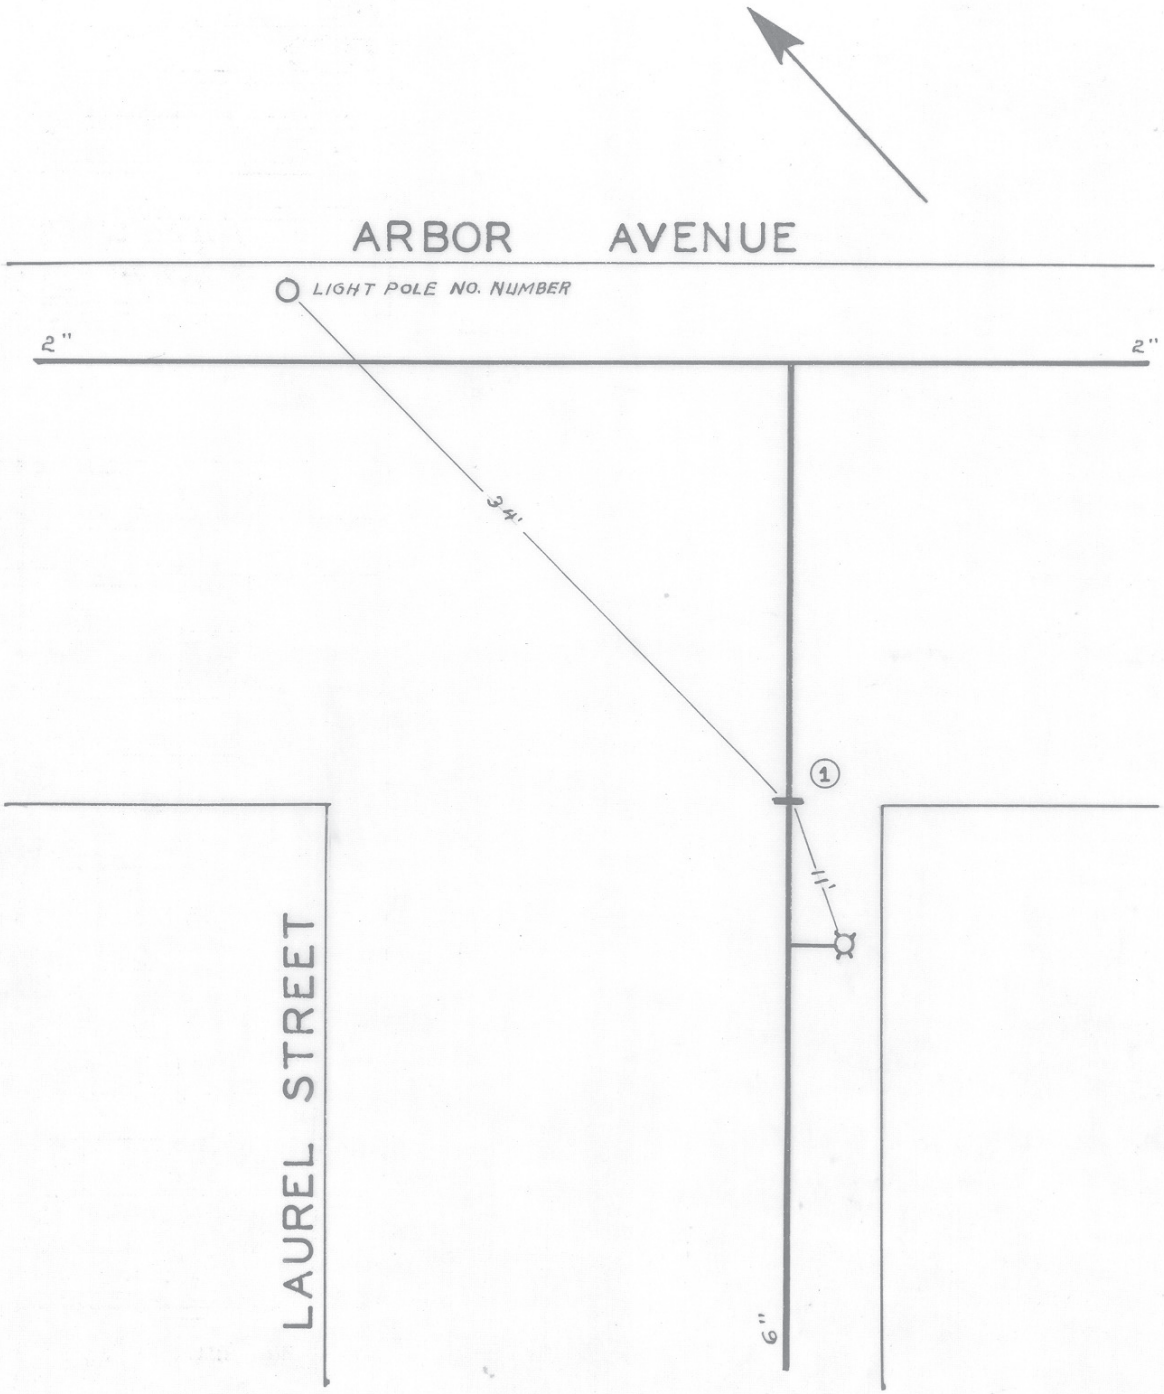

DATE	NO.	SIZE	MAKE	OPEN	TURNS
'59	1	2"	DARLING	R	
	1	0'	S.P.L.		

CITY OF ROANOKE — WATER DEPT.

VALVE DIAGRAM

ARBOR AVENUE &

LAUREL STREET S.E.

SEC. MAP 403

DATE PAGE NO.

"IMPERIAL" TRACING CLOTH
K & E CO., N.Y.