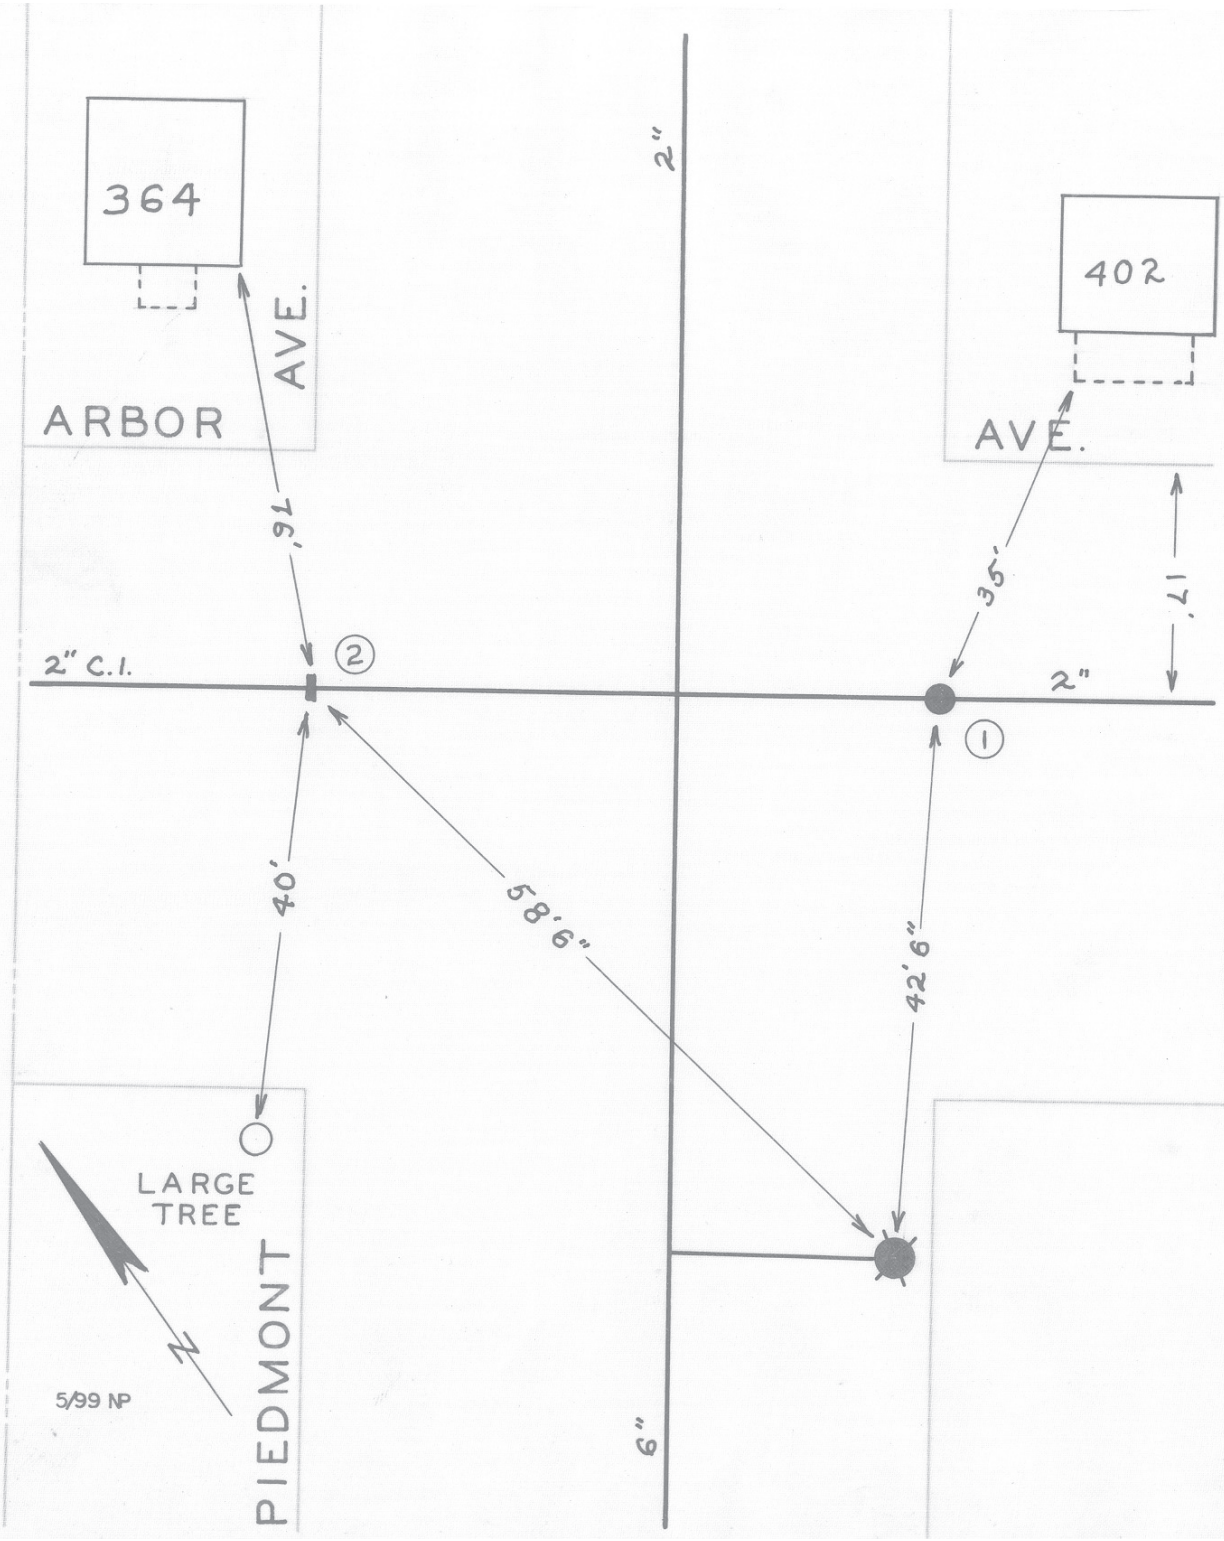

DATE	NO.	SIZE	MAKE	OPEN	TURNS
1955	1	2"			
1925	2	2"			
	1	0	EPL		
	2	5'-E	WPL		

CITY OF ROANOKE—WATER DEP'T

VALVE DIAGRAM

ARBOR AVENUE &

PIEDMONT AVENUE S.E.

SEC. MAP 415,403 S.E.

DATE PAGE NO.