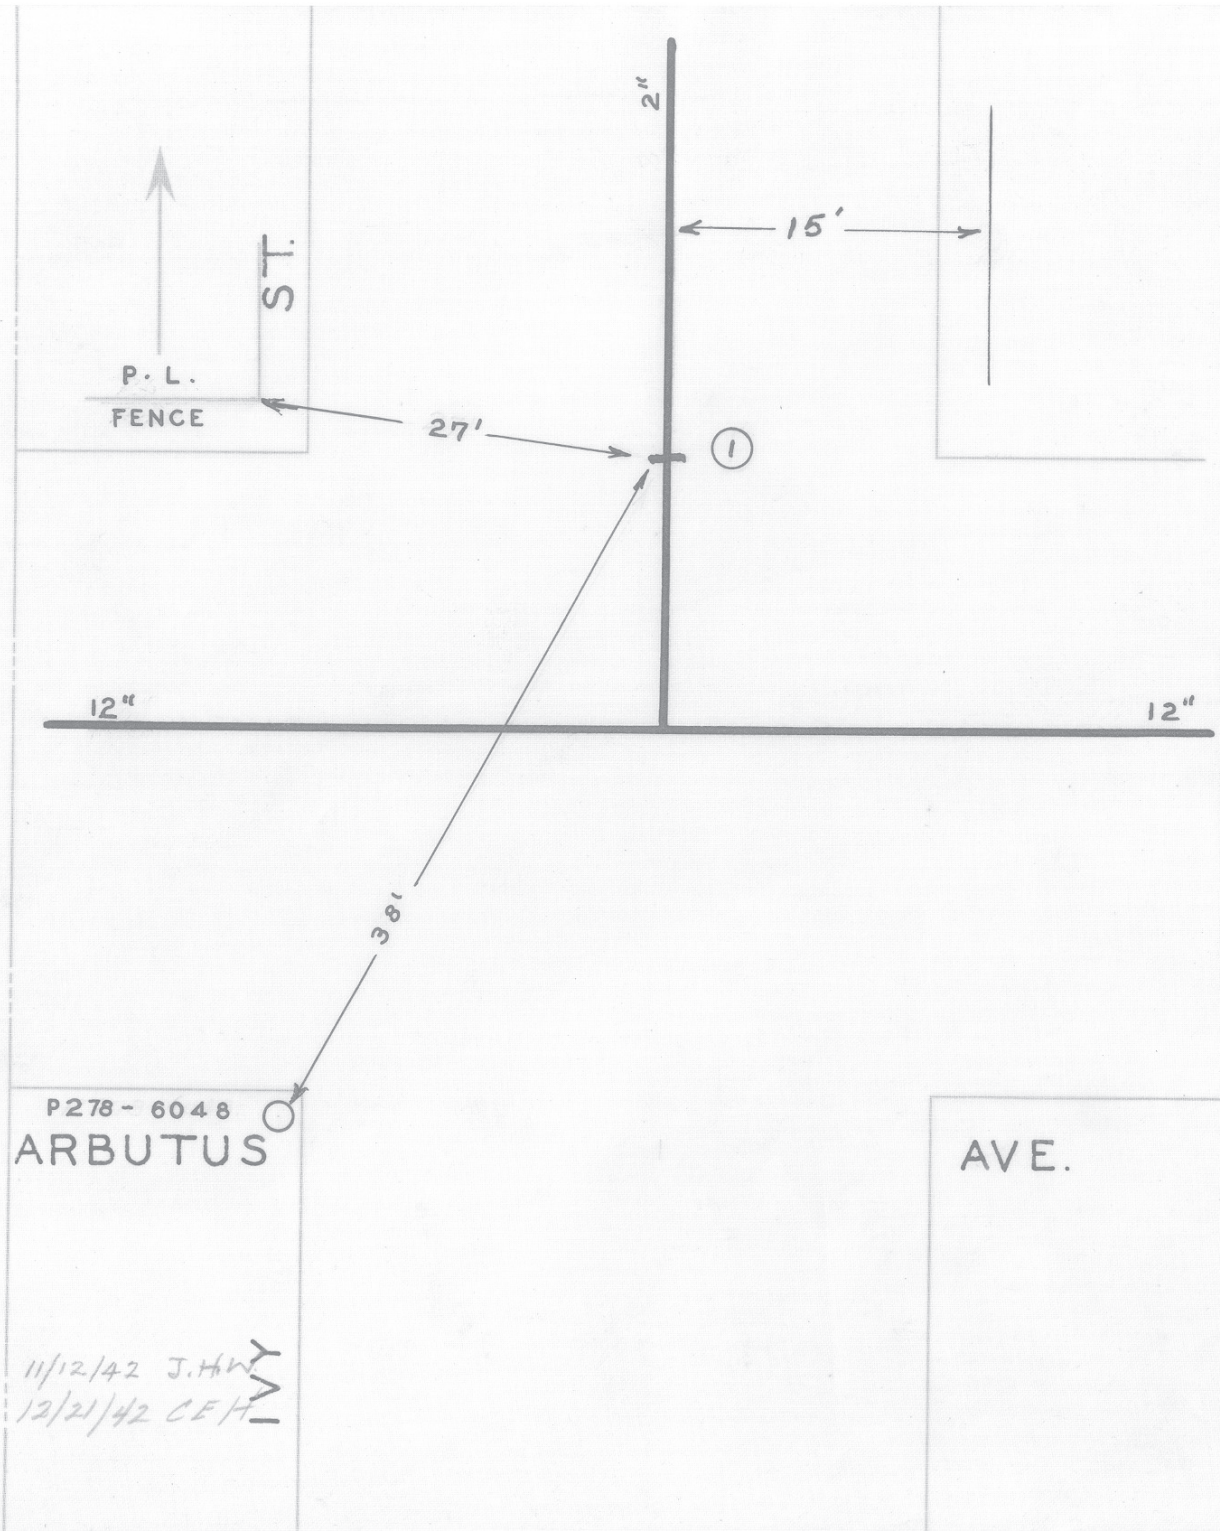

DATE	NO.	SIZE	MAKE	OPEN	TURNS
1925	1	2"		L	8 1/2
	1	12"-S	NPL		

CITY OF ROANOKE—WATER DEP'T

VALVE DIAGRAM

ARBUTUS AVE. & IVY. ST. S. E.

SEC. MAP 403

DATE

PAGE NO. S.E. 75