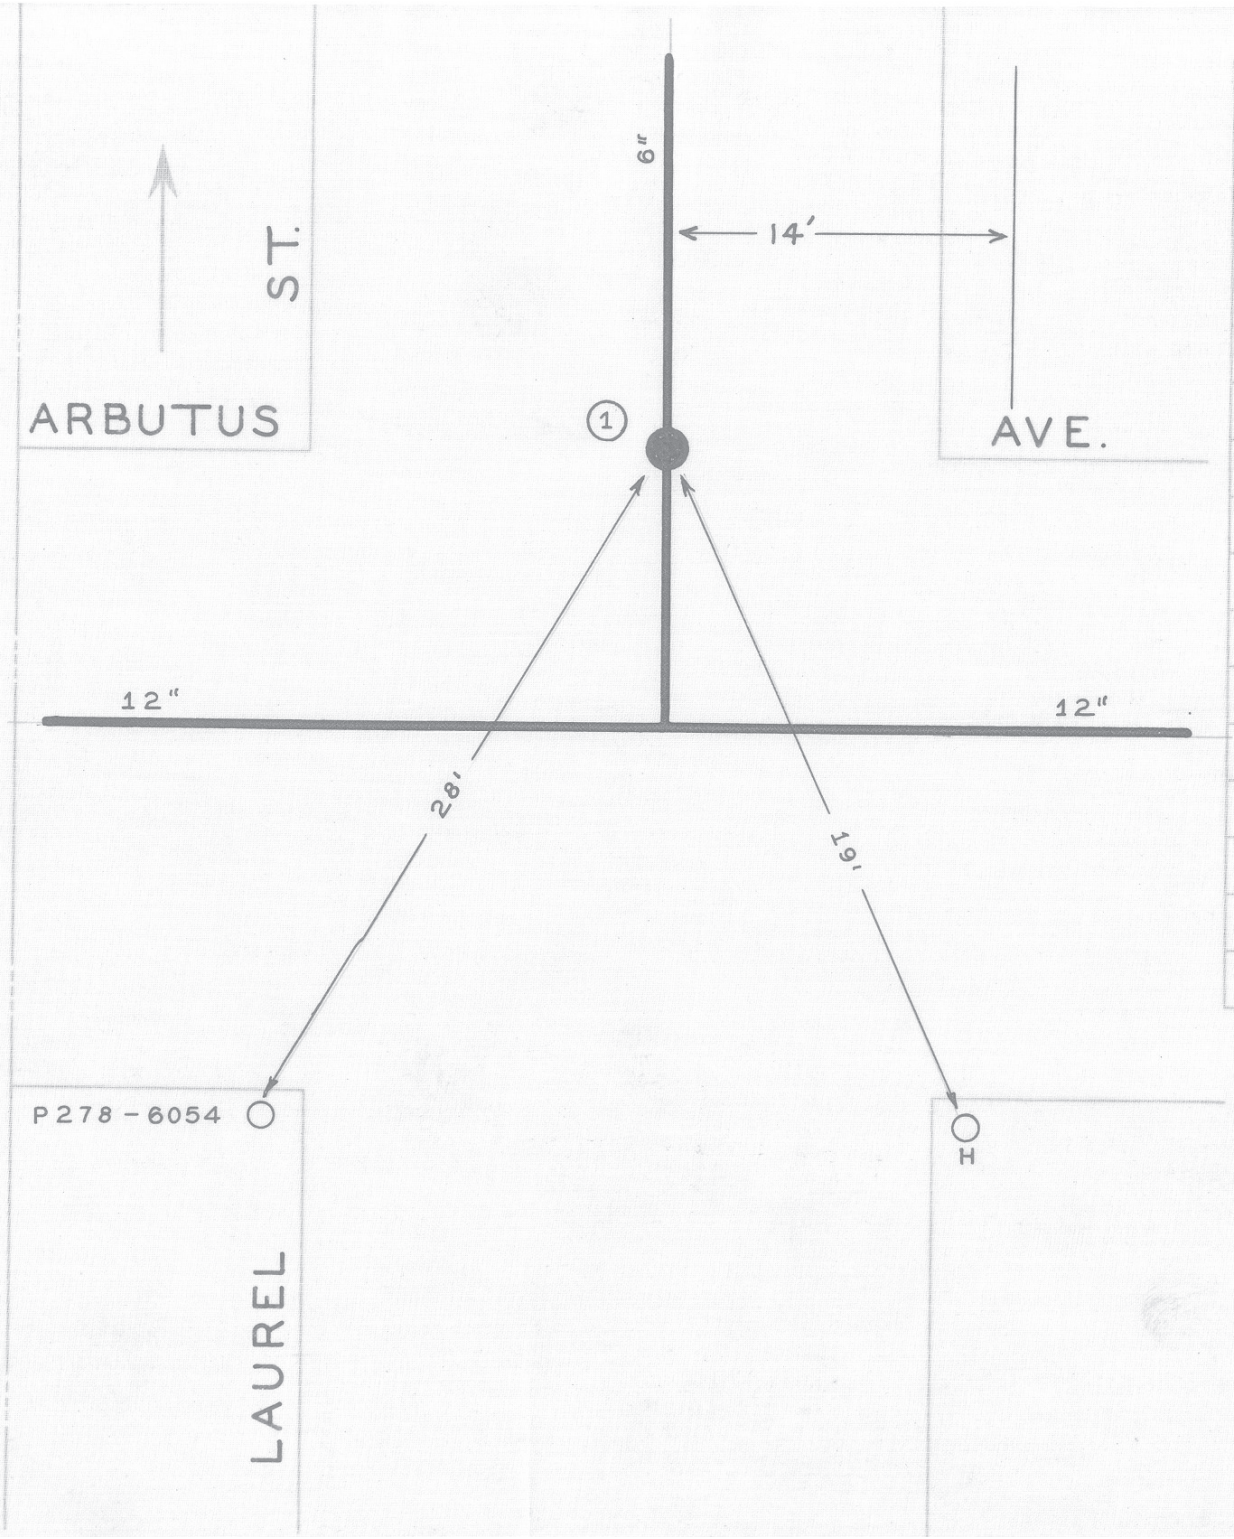

DATE	NO.	SIZE	MAKE	OPEN	TURNS
1947	1	6"	DARLING	R	21
	I	31'-S	NPL		

CITY OF ROANOKE—WATER DEP'T

VALVE DIAGRAM

ARBUTUS AVENUE & LAUREL ST. S.E.

SEC. MAP 403

DATE 1/31/47 PAGE NO S.E.257