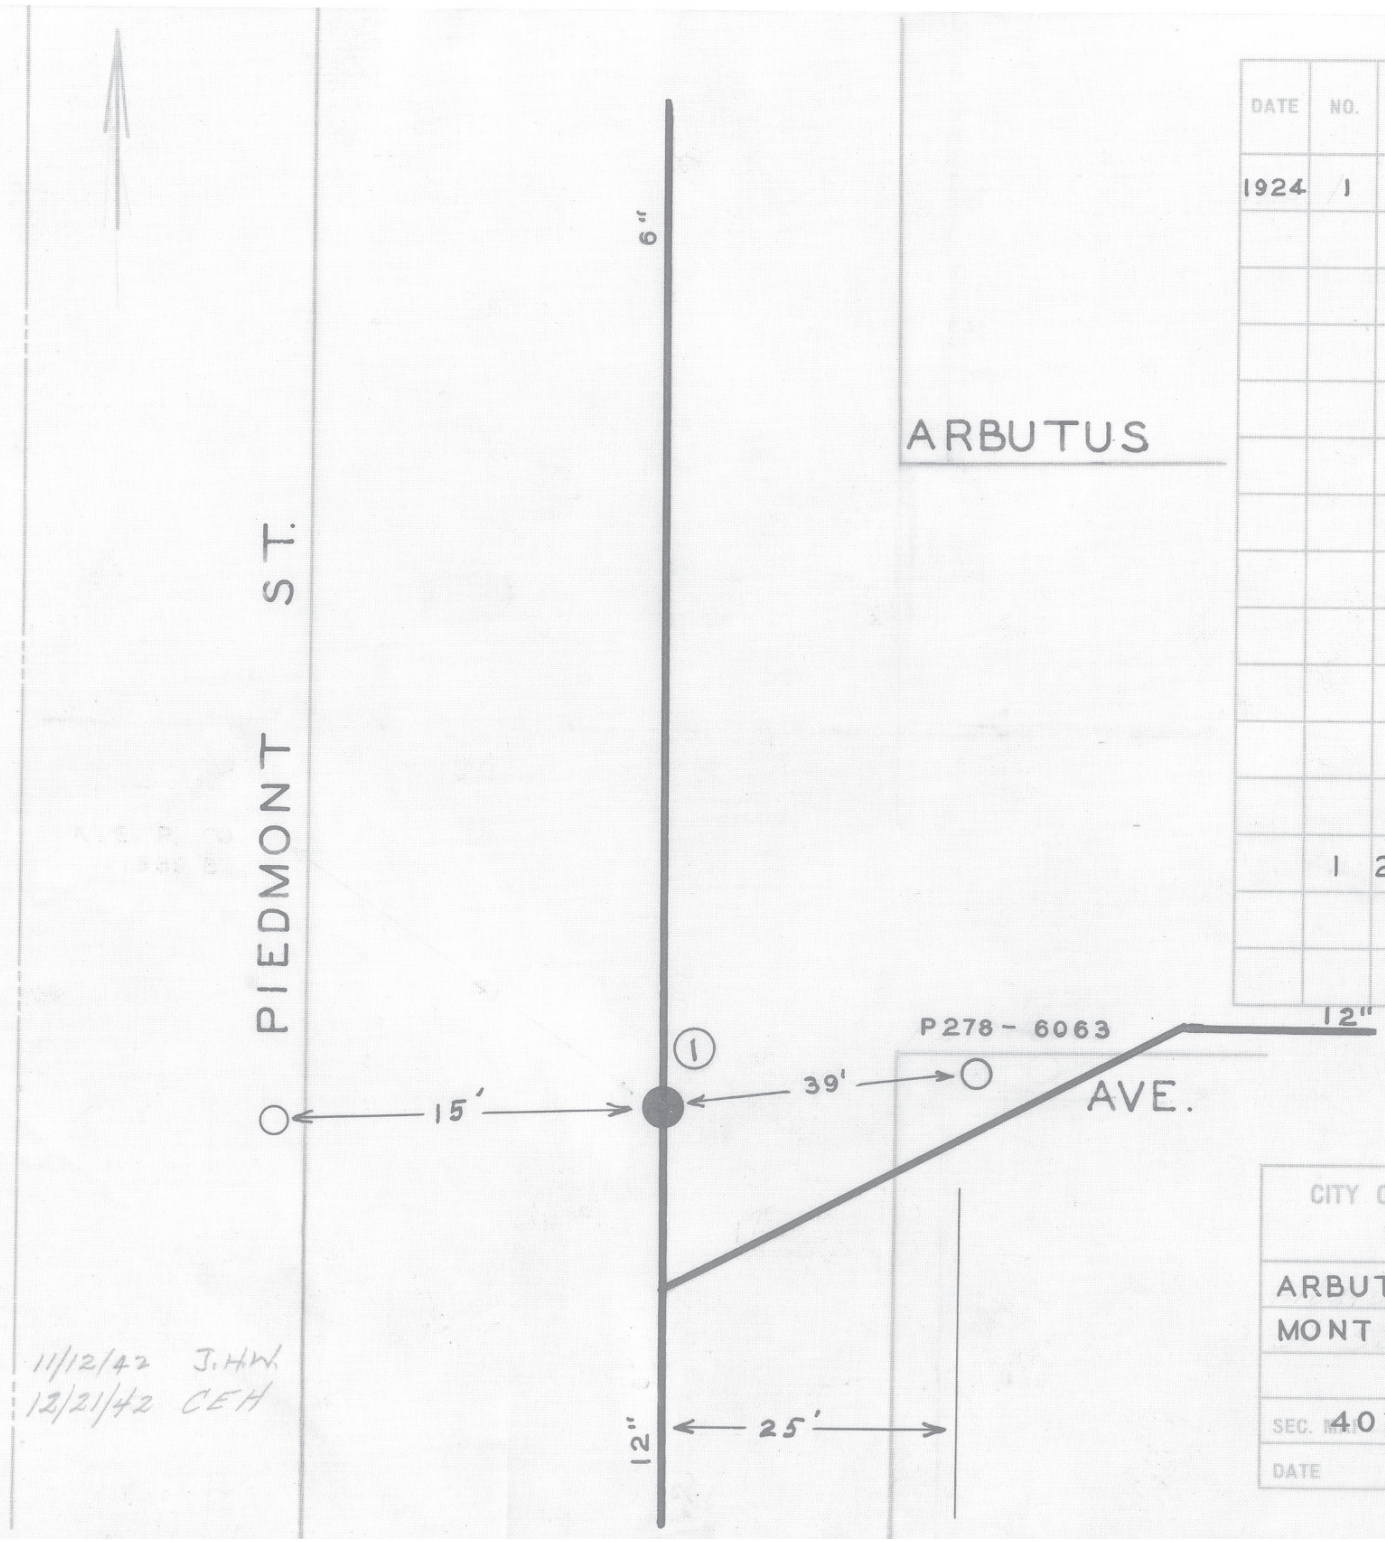

DATE	NO.	SIZE	MAKE	OPEN	TURNS
1924	1	6"		R	19
	1	21-S	SPL		

11/12/42 J.H.W.
12/21/42 CEH

CITY OF ROANOKE—WATER DEP'T
VALVE DIAGRAM

ARBUTUS AVE. & PIEDMONT ST. S.E.

SEC. NO. 403

DATE

PAGE NO. S.E.74