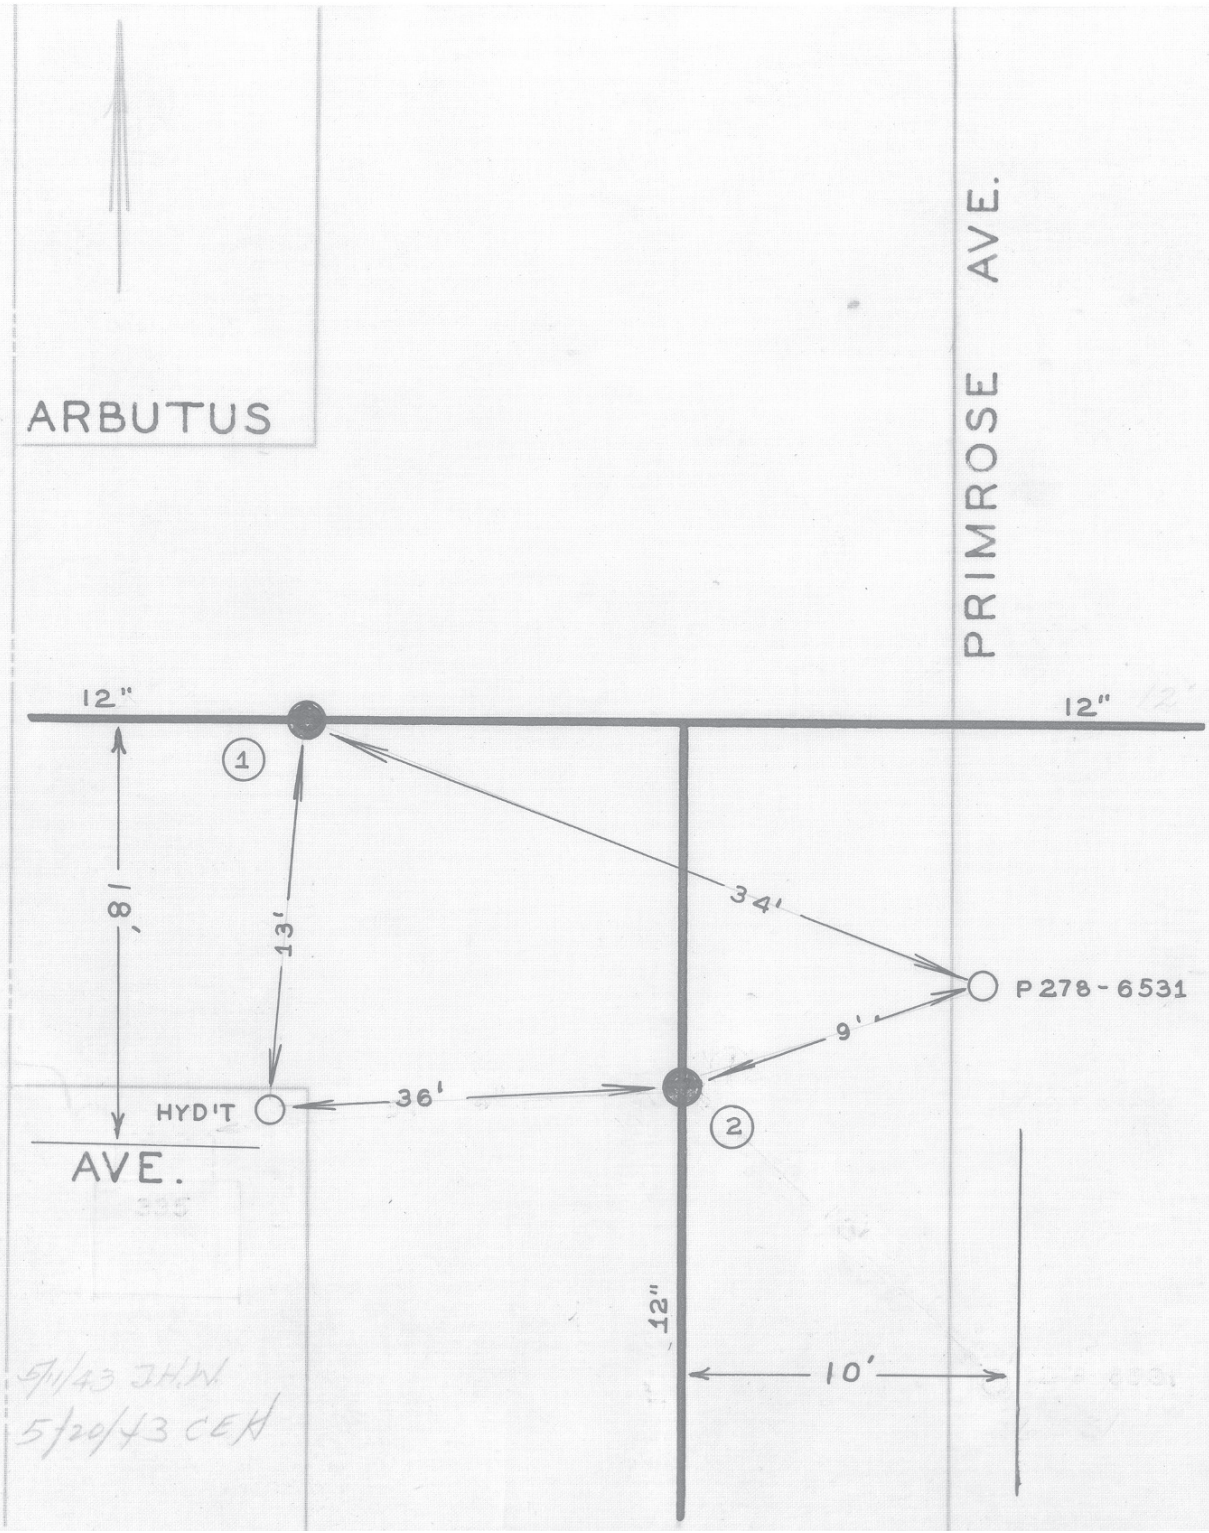

DATE	NO.	SIZE	MAKE	OPEN	TURNS
1948	1	12"	DARLING	R	39
1948	2	12"	DARLING	R	39
	1	0	WPL		
	2	0	SPL		

CITY OF ROANOKE—WATER DEP'T

VALVE DIAGRAM

ARBUTUS AVENUE &

PRIMROSE ST. S.E.

SEC. MAP 416

DATE

PAGE NO. S.E.88