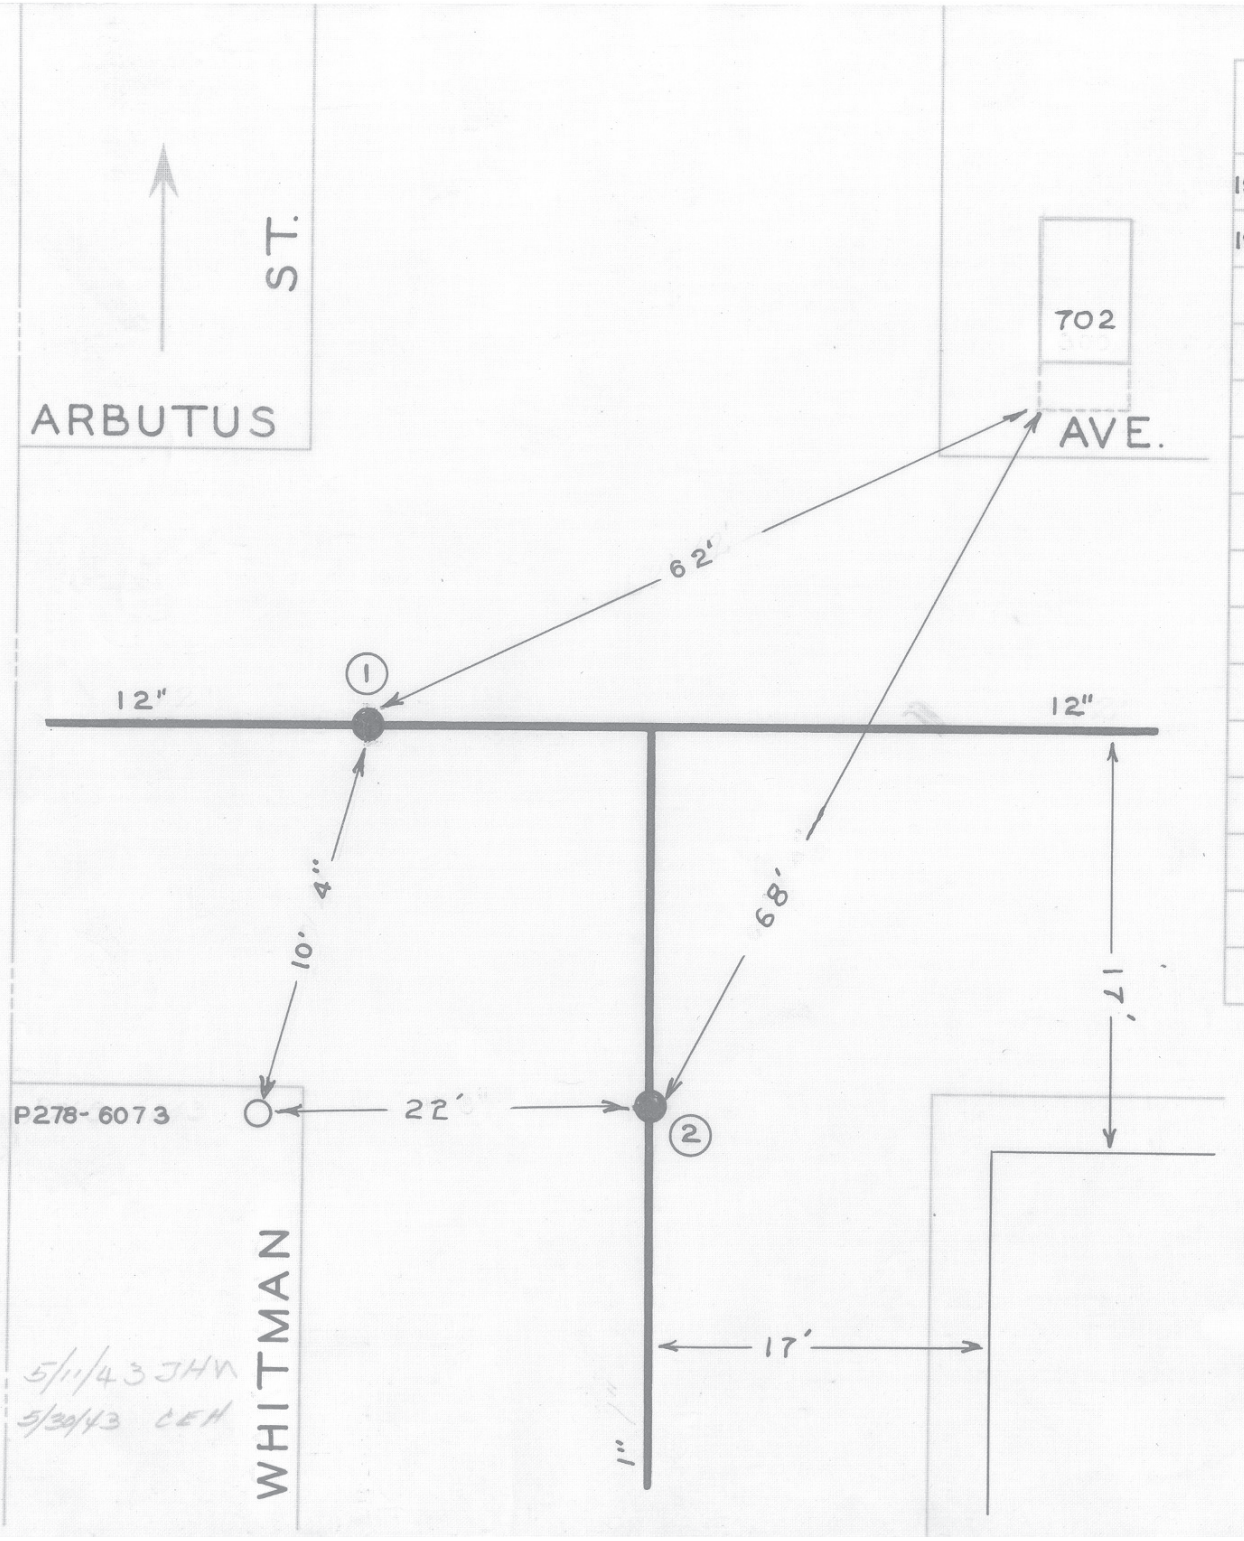

DATE	NO.	SIZE	MAKE	OPEN	TURNS
1910	1	12"		R	38
1924	2	2"	DARLING	R	7
	1	0	WPL		
	2	0	SPL		

CITY OF ROANOKE—WATER DEP'T

VALVE DIAGRAM

ARBUTUS AVE. &

WHITMAN ST. S.E.

SEC. MAP 415

DATE

PAGE NO S.E.87