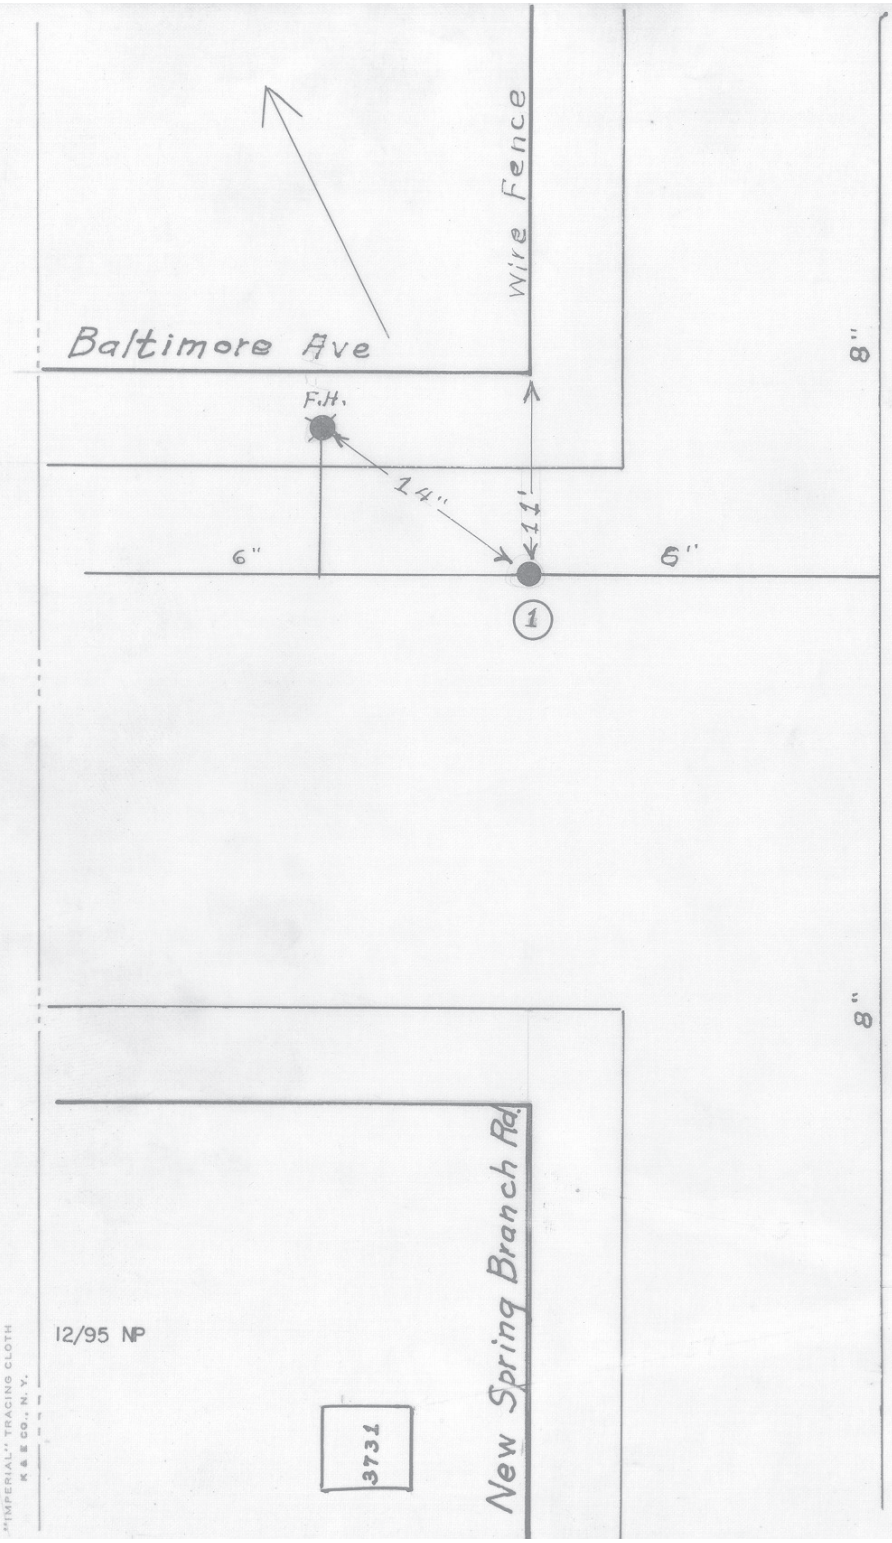

DATE	NO.	SIZE	MAKE	OPEN	TURNS
1953	1	6"	Mueller	R	20
	1	0'	W.P.L.		

CITY OF ROANOKE—WATER DEPT.

VALVE DIAGRAM

Baltimore Avenue & New Spring Branch Road S.E.

SEC. MAP 430

DATE PAGE NO.

"IMPERIAL" TRACING CLOTH K & E CO., N. Y.