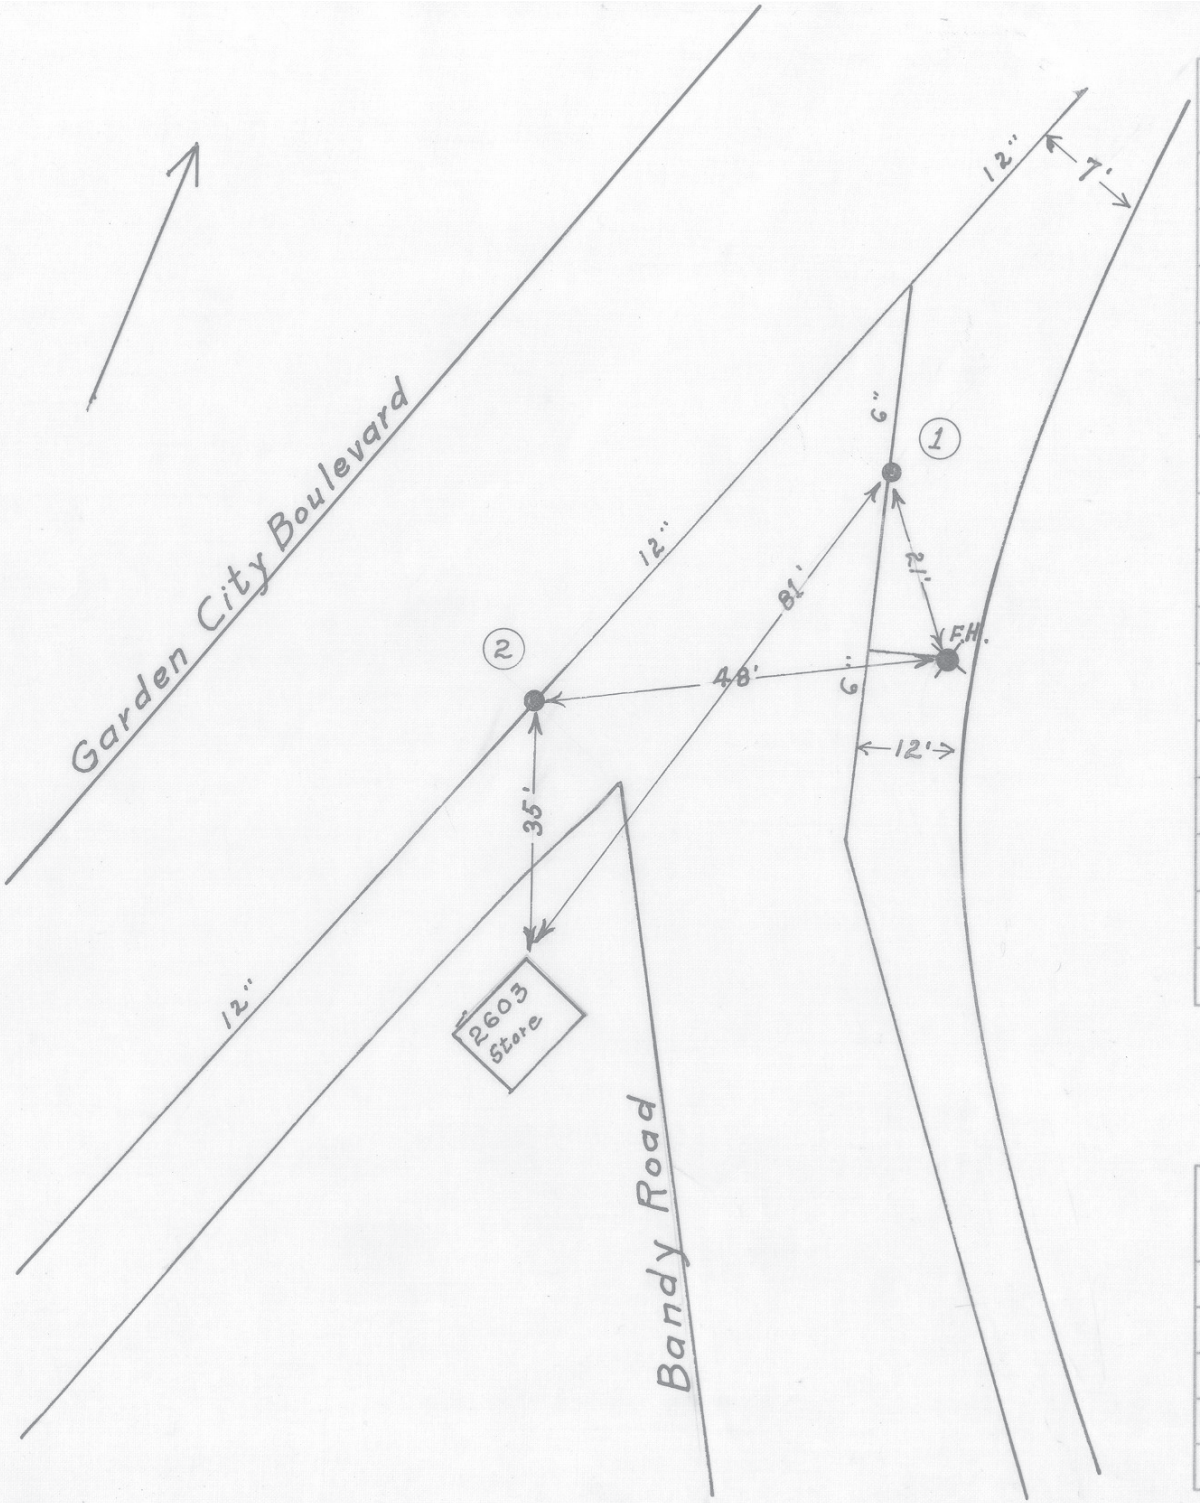

DATE	NO.	SIZE	MAKE	OPEN	TURNS
	1	6"			
	2	12"			
	1	0'	E.P.L.		
	2	0'	S.P.L.		

CITY OF ROANOKE — WATER DEPT.

VALVE DIAGRAM

Bandy Road &
Garden City Boulevard

SEC. MAP 437

DATE PAGE NO.

"IMPERIAL" TRACING CLOTH
K & E CO., N. Y.