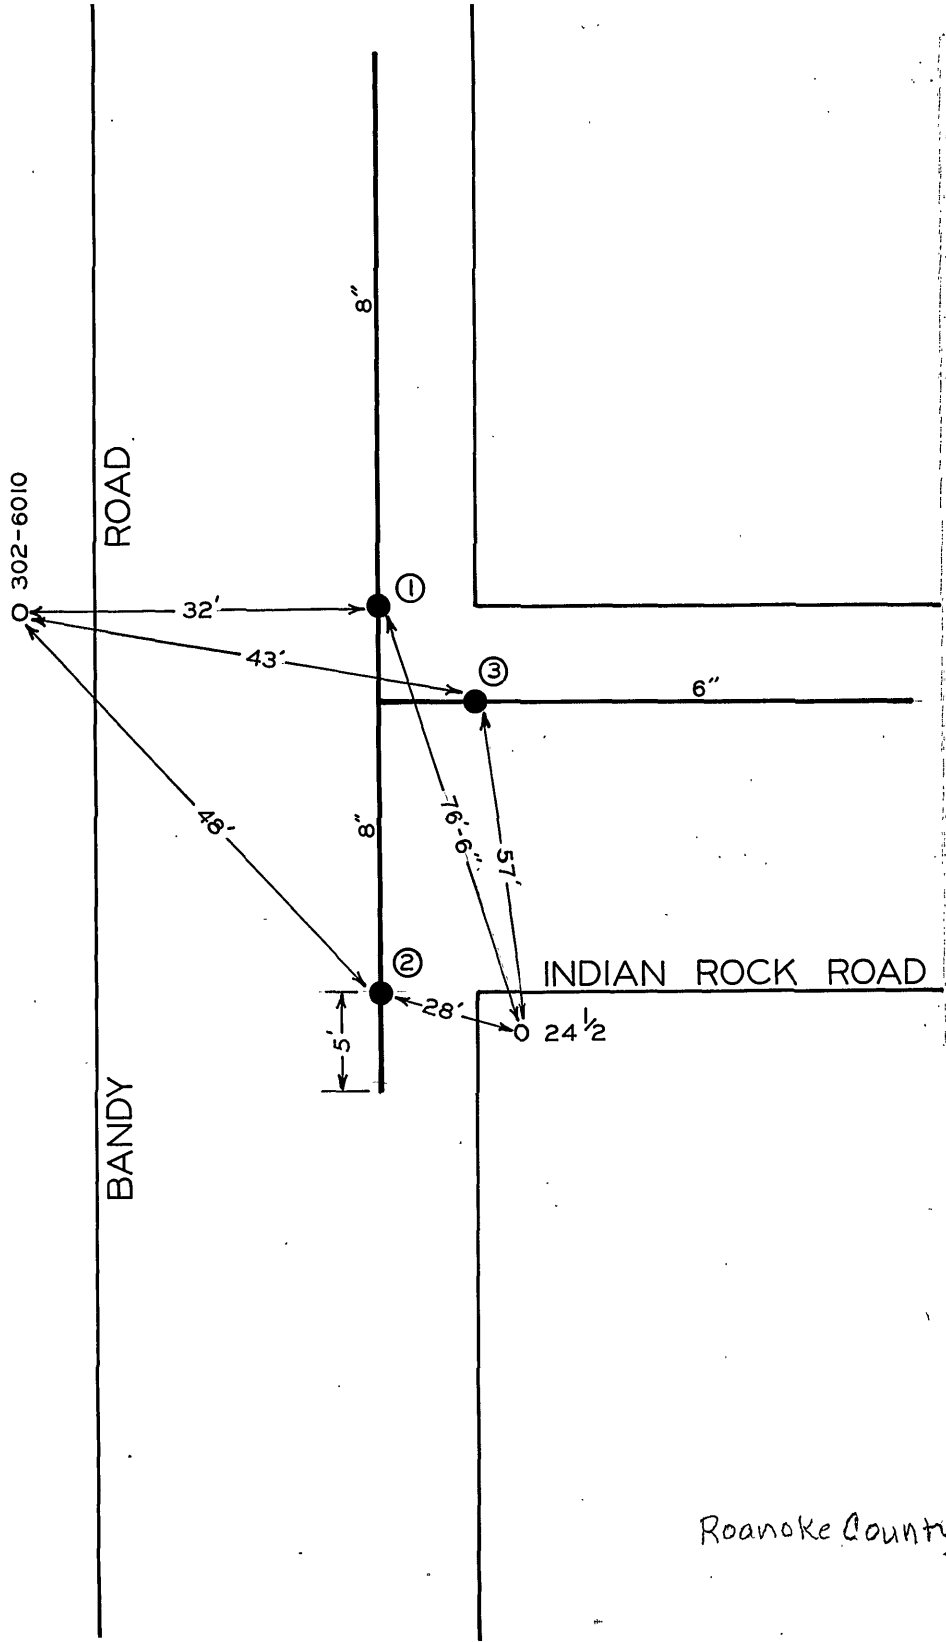

DATE	NO.	SIZE	[illegible]	[illegible]	[illegible]
73	1	8"	MUELLER	R	27
73	2	8"	MUELLER	R	27
73	3	6"	MUELLER	R	21
	1	13'-W	E.P.L.		
	2	13'-W	E.P.L.		

[illegible]

BANDY ROAD & INDIAN ROCK ROAD S.E.

[illegible] 83

Roanoke County