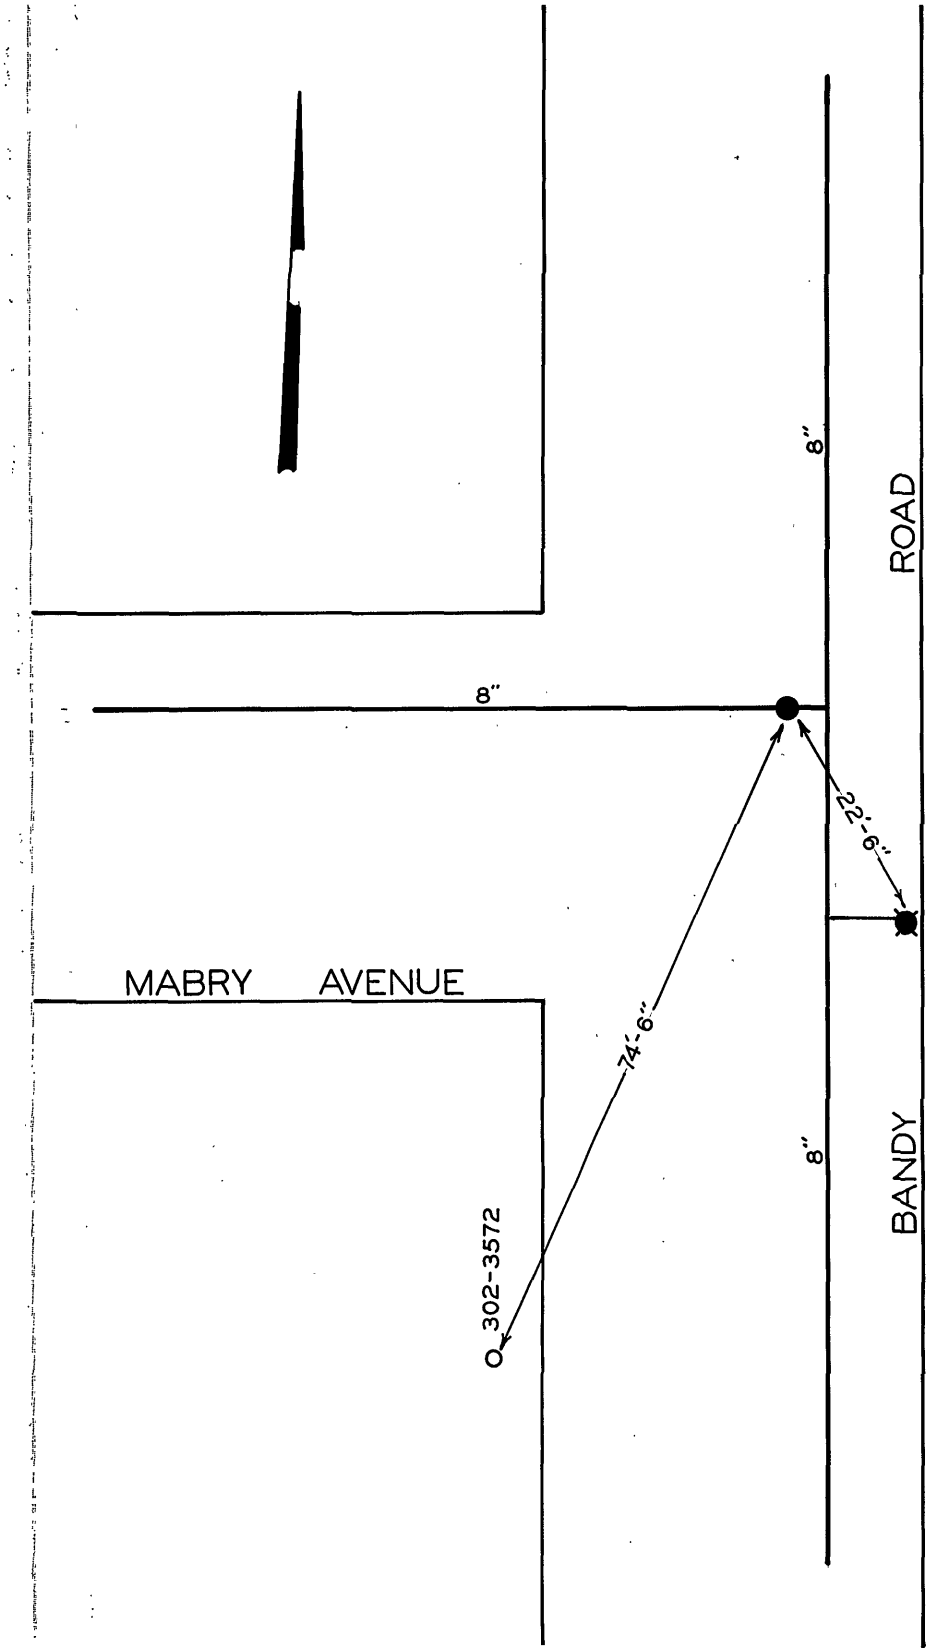

DATE	NO.	SIZE	MAKE	OPEN	TURNS
73	1	8"	MUELLER	R	27

CITY OF ROANOKE — WATER DEPT
VALVE DIAGRAM

BANDY ROAD &
MABRY AVENUE S.E.

SEC MAP 439

DATE PAGE NO.