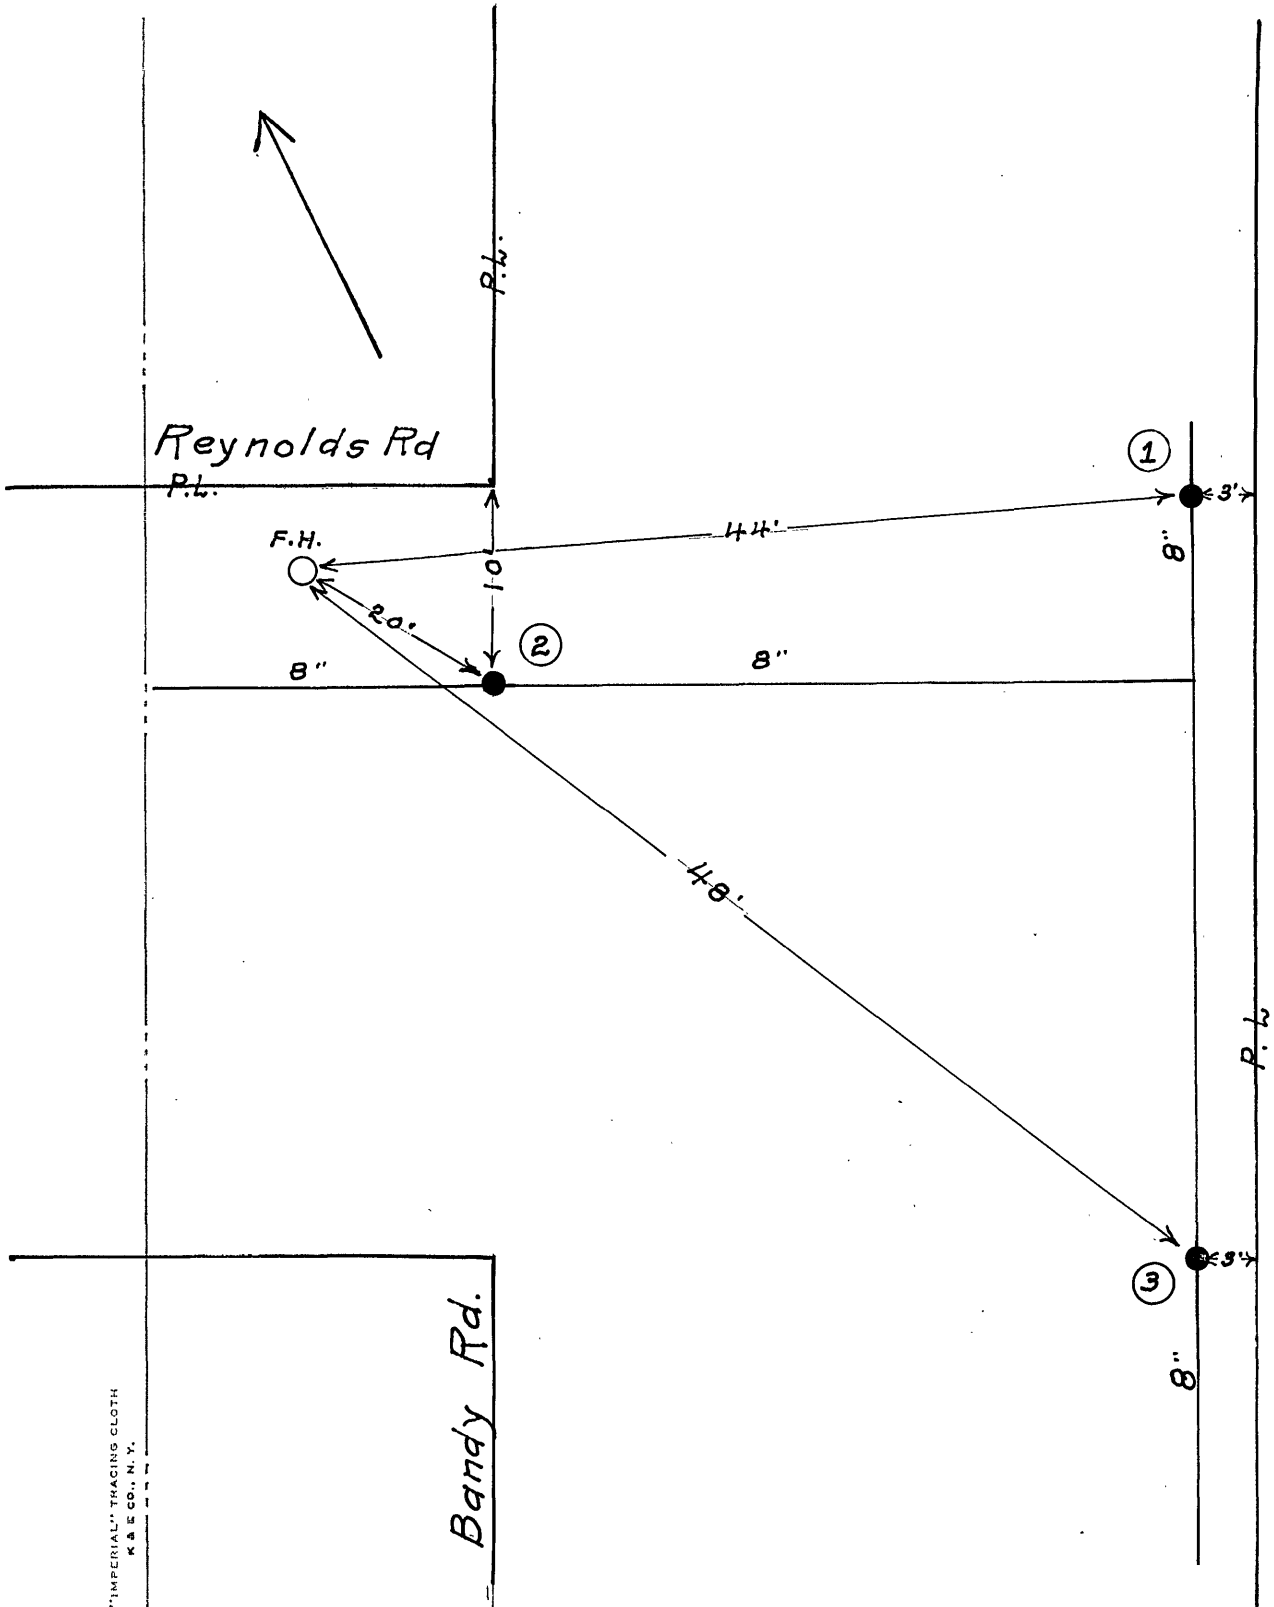

DATE	NO.	SIZE	MAKE	OPEN	TURNS
	1	8"	Mueller	R	27
	2	8"	Mueller	R	27
	3	8"	Mueller	R	27

CITY OF ROANOKE — WATER DEPT.

VALVE DIAGRAM

Bandy Road & Reynolds Road S.E.

SEC. MAP 438

DATE PAGE NO.