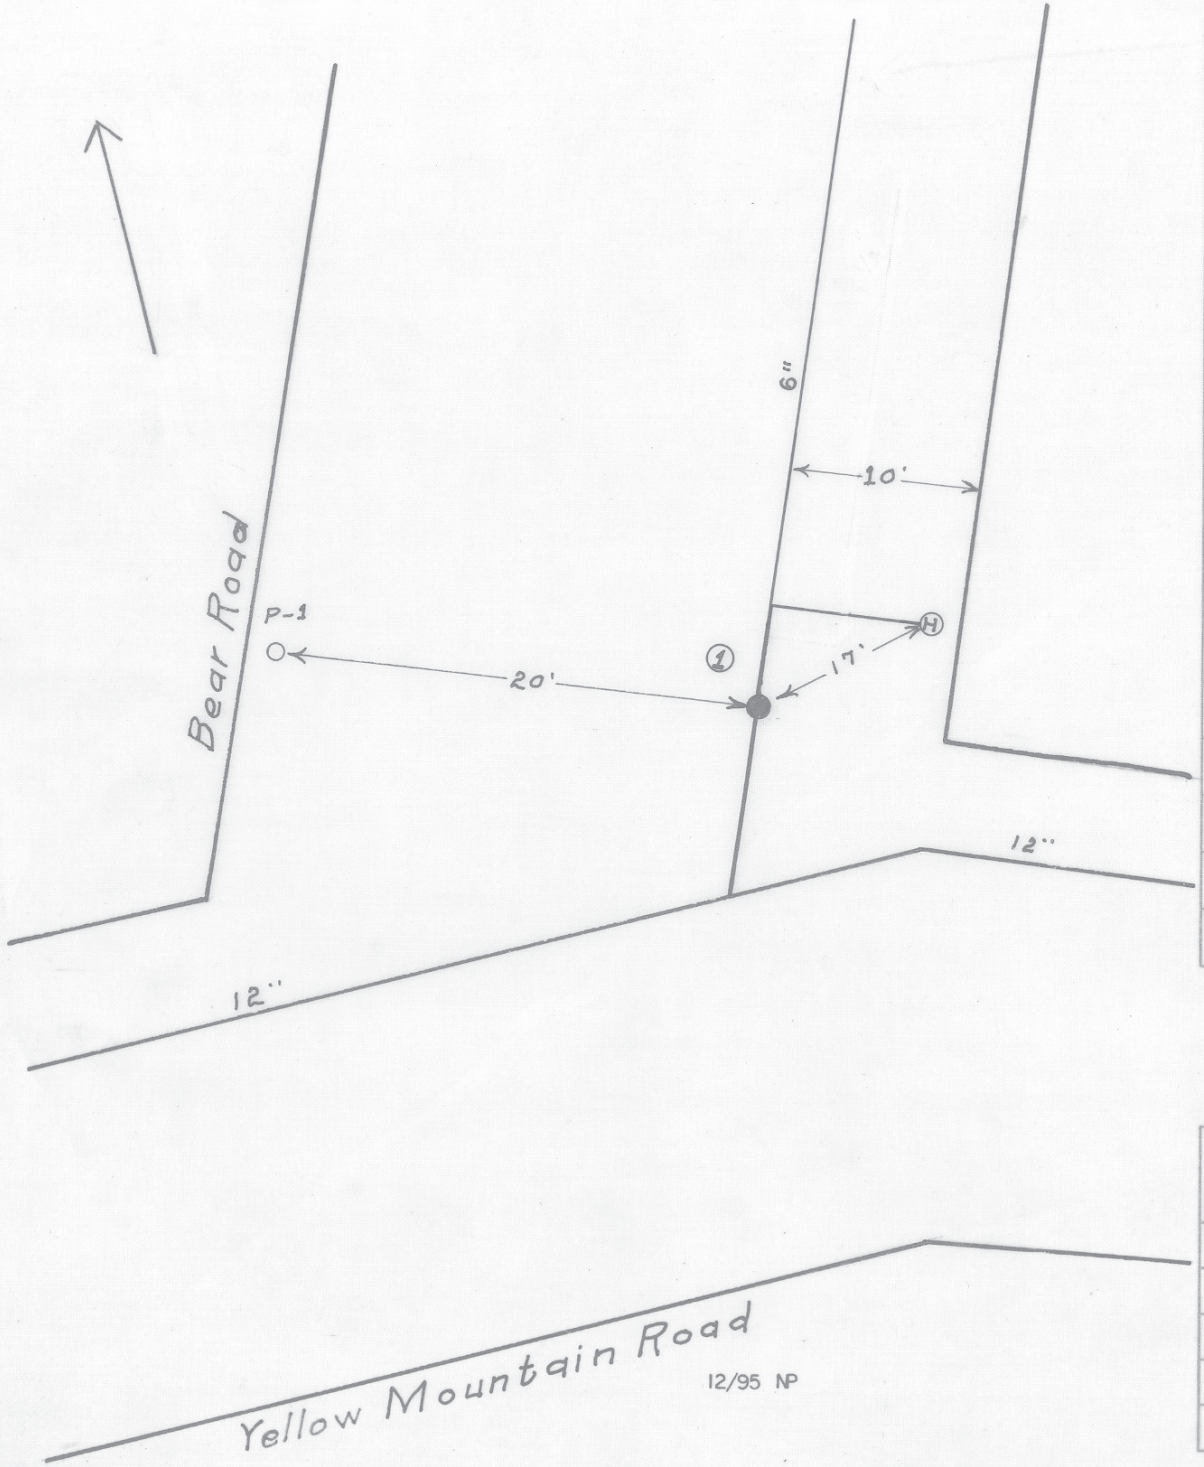

DATE	NO.	SIZE	MAKE	OPEN	TURNS
1953	1	6"	Mueller	R	20
	1	0'	N.P.L.		

CITY OF ROANOKE — WATER DEPT.

VALVE DIAGRAM

Bear Rd. & Yellow Mountain Road

SEC. MAP 430 S.E.

DATE PAGE NO.

"IMPERIAL" TRACING CLOTH K & E CO., N. Y.