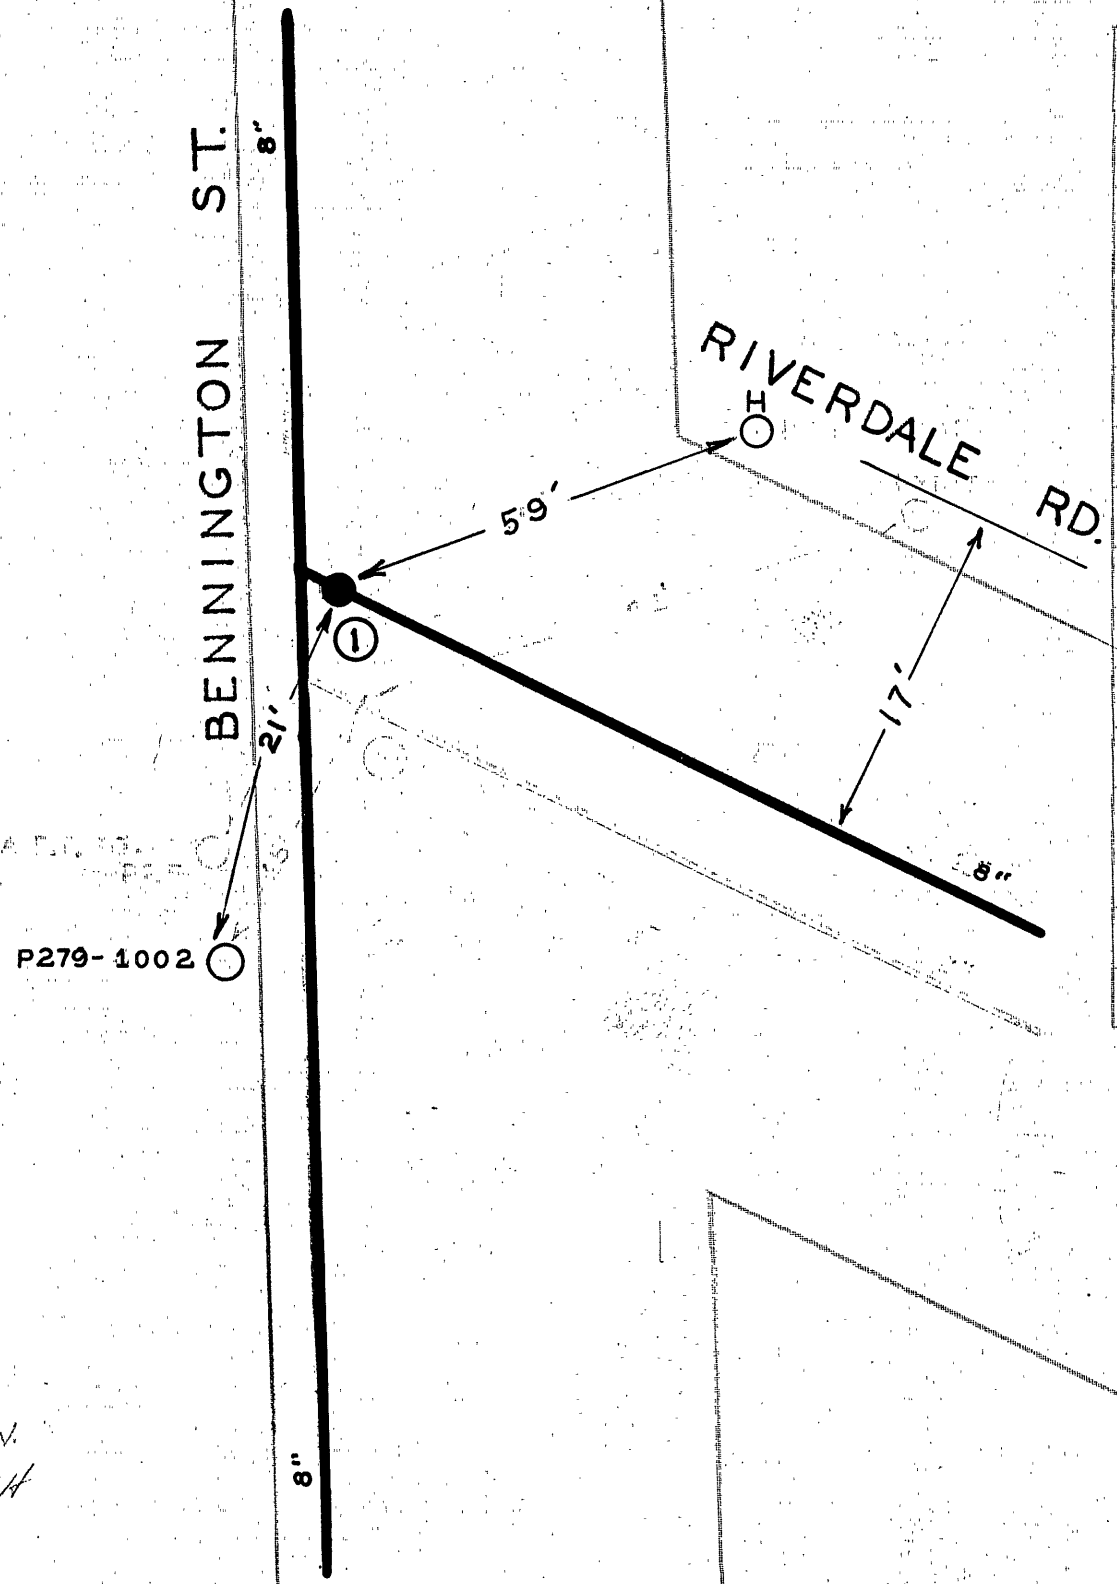

DATE	NO.	SIZE	MAKE	OPEN	TURNS
1917	1	6"		R	13
[illegible]	2	2"	[illegible]	R	7
	1	40'-W	EPL		

CITY OF ROANOKE WATER DEPT

VALVE DIAGRAM

BENNINGTON STREET & RIVERDALE ROAD S.E.

SEC. MAP 434

DATE

PAGE NO. S.E.100

9/12/43 J.H.N.
5/20/43 CEH