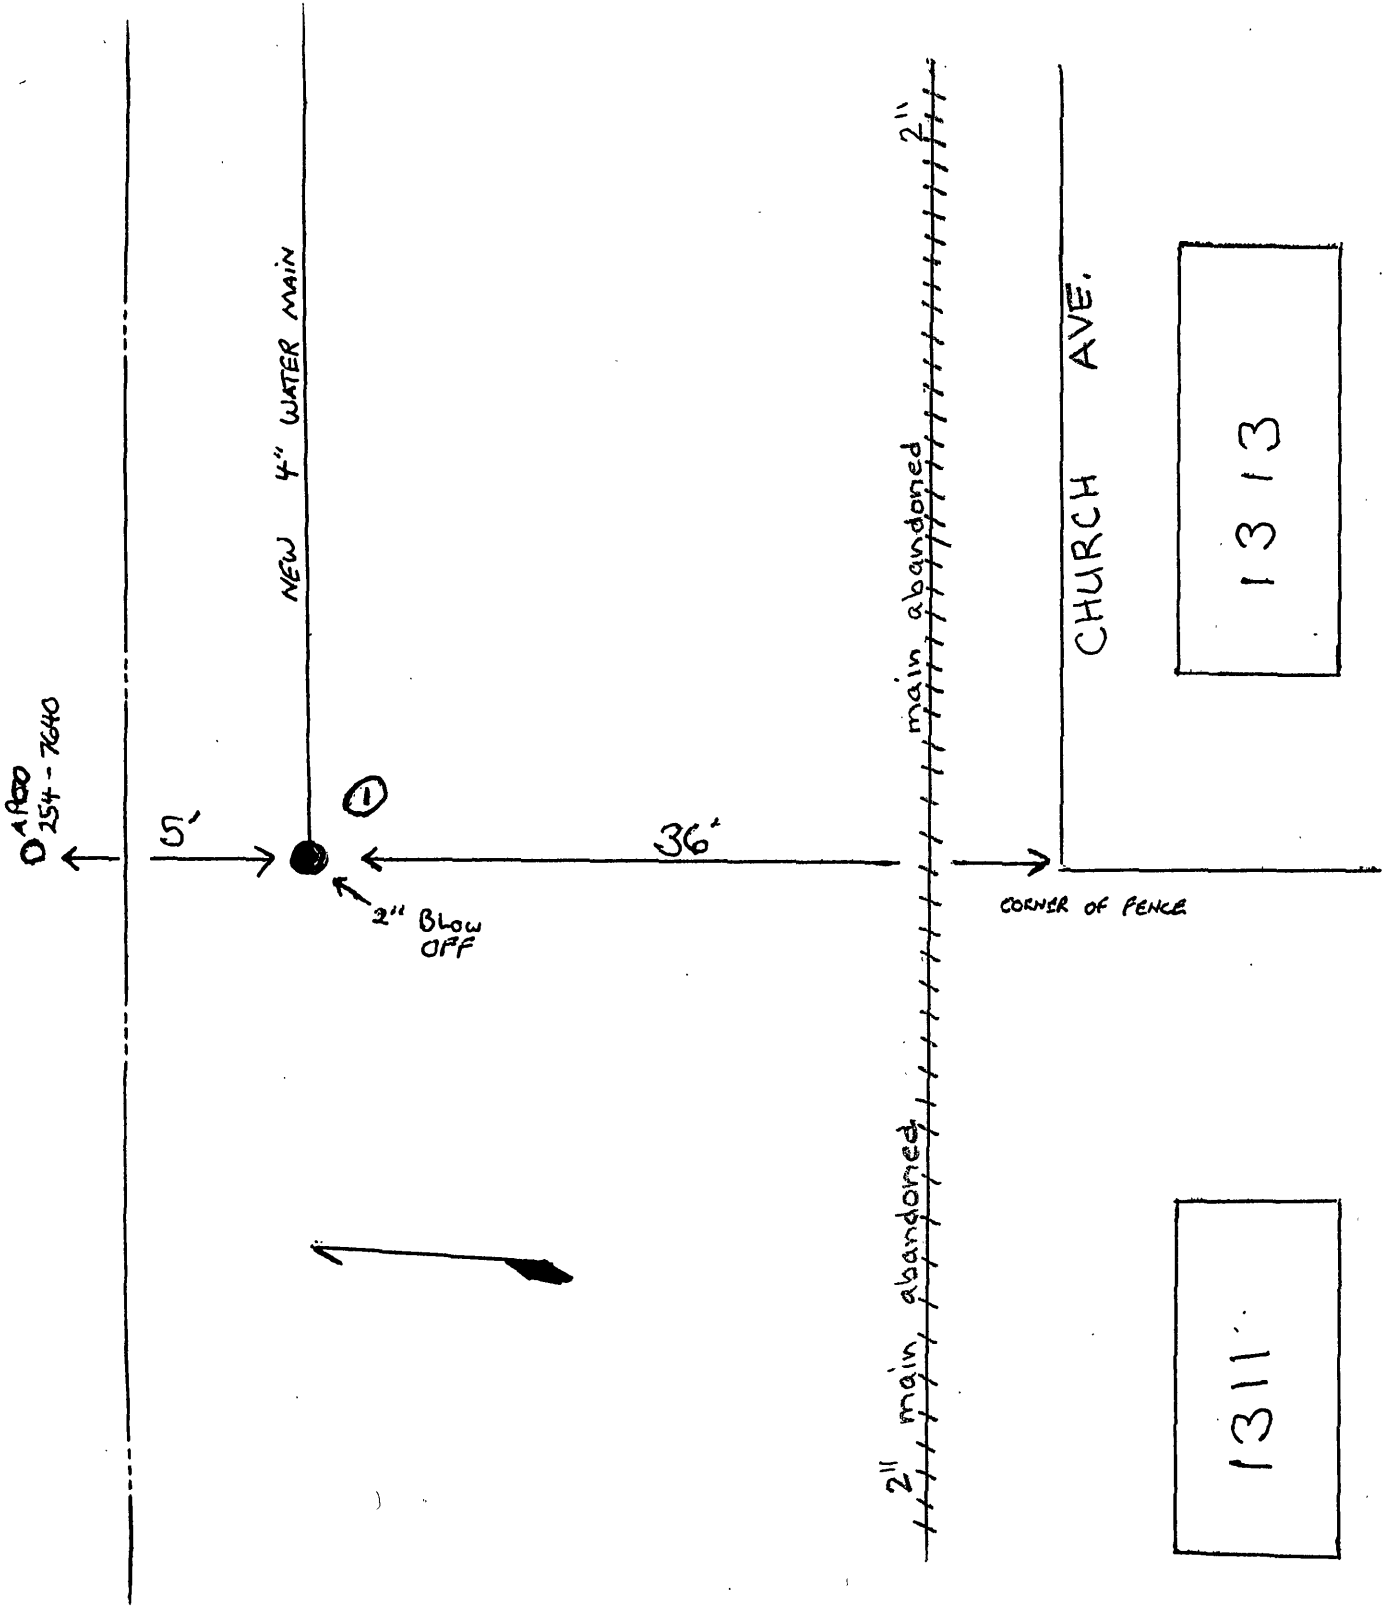

DATE	NO.	SIZE	MAKE	OPEN	TURNS
10-96	1	2	misc	L	

CITY OF ROANOKE—WATER DEP'T
VALVE DIAGRAM
1300 Block of CHURCH AVE SE.
SEC. MAP 411
DATE 11-8-96 PAGE NO.