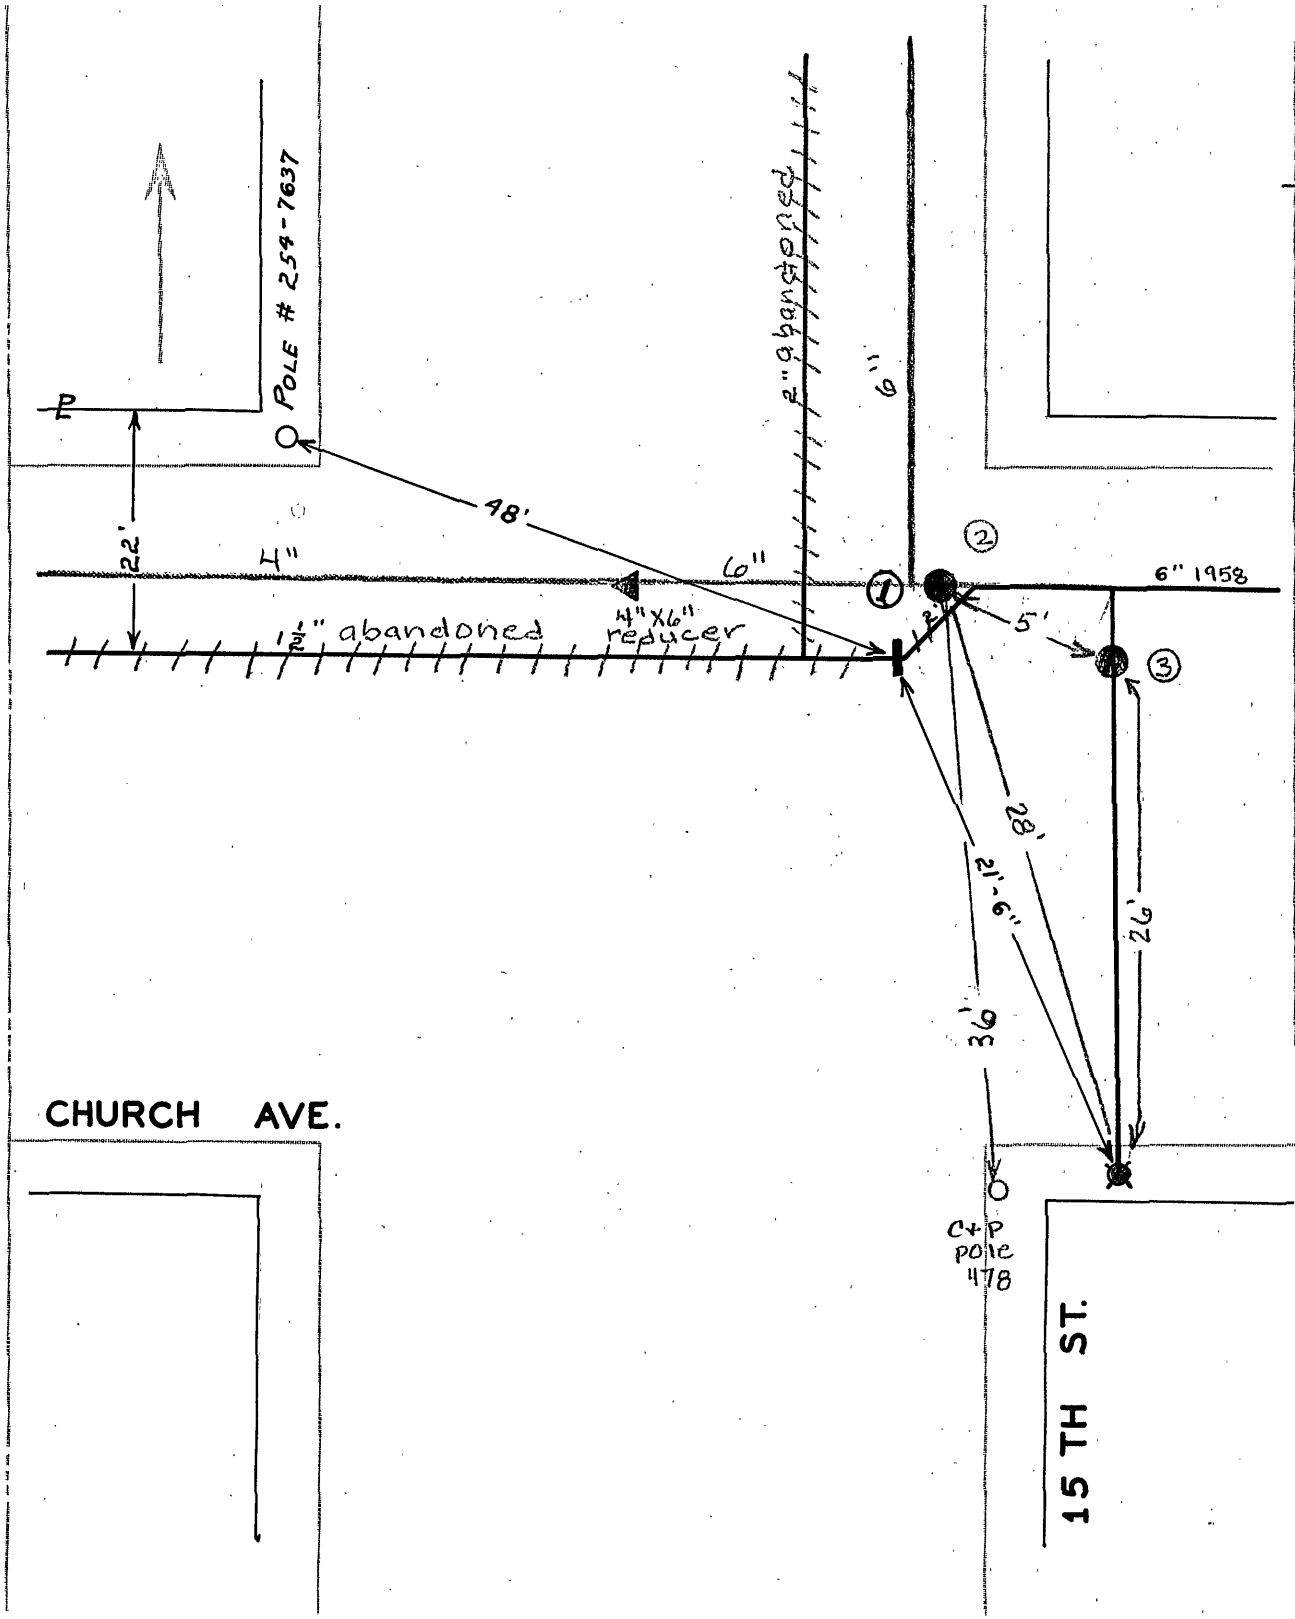

DATE	NO.	SIZE	MAKE	OPEN	TURNS
~~60~~	~~1~~	~~2"~~	~~MISC.~~	~~L~~	
1996	2	6"	MUELLER	R	21
1996	3	6"	MUELLER	R	21
	1	46'E	W.P.L.		

CITY OF ROANOKE—WATER DEP'T

VALVE DIAGRAM

CHURCH AVENUE &

15TH STREET S.E.

SEC. MAP 421

DATE PAGE NO.