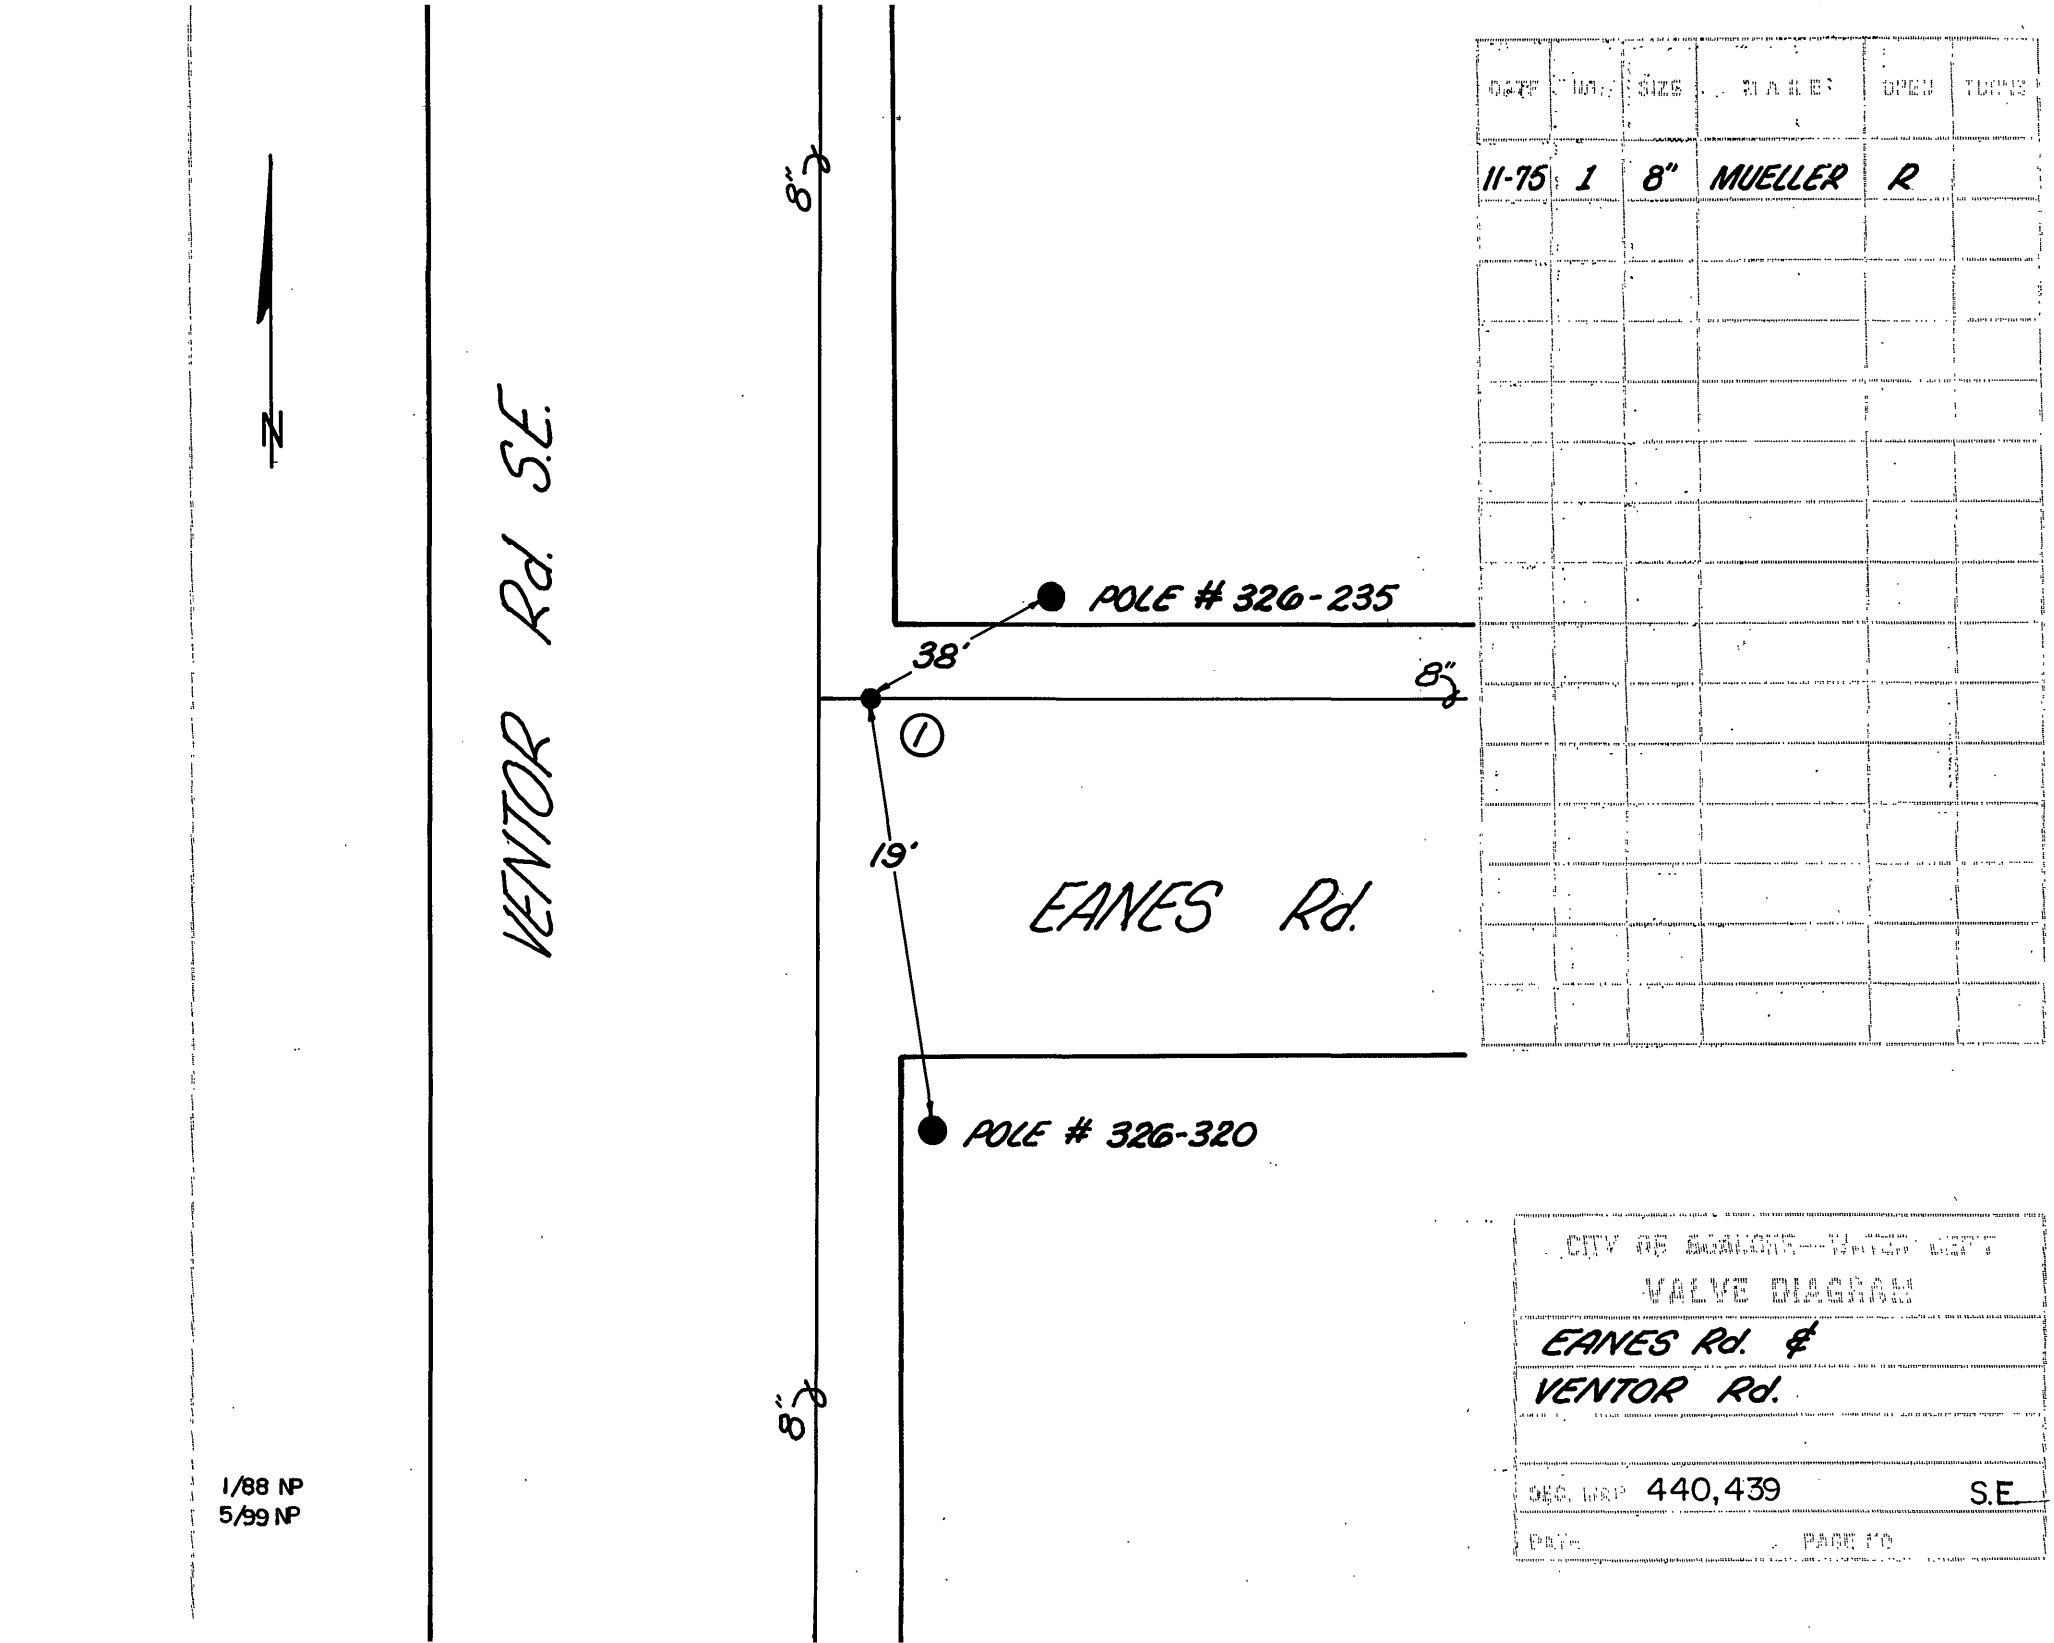

DATE	NO.	SIZE	MAKE	OPEN	TURNS
11-75	1	8"	MUELLER	R	

1/88 NP
5/99 NP


VALVE DIAGRAM

EANES Rd. &
VENTOR Rd.

DES. MAP 440,439 S.E.

DATE PAGE 19