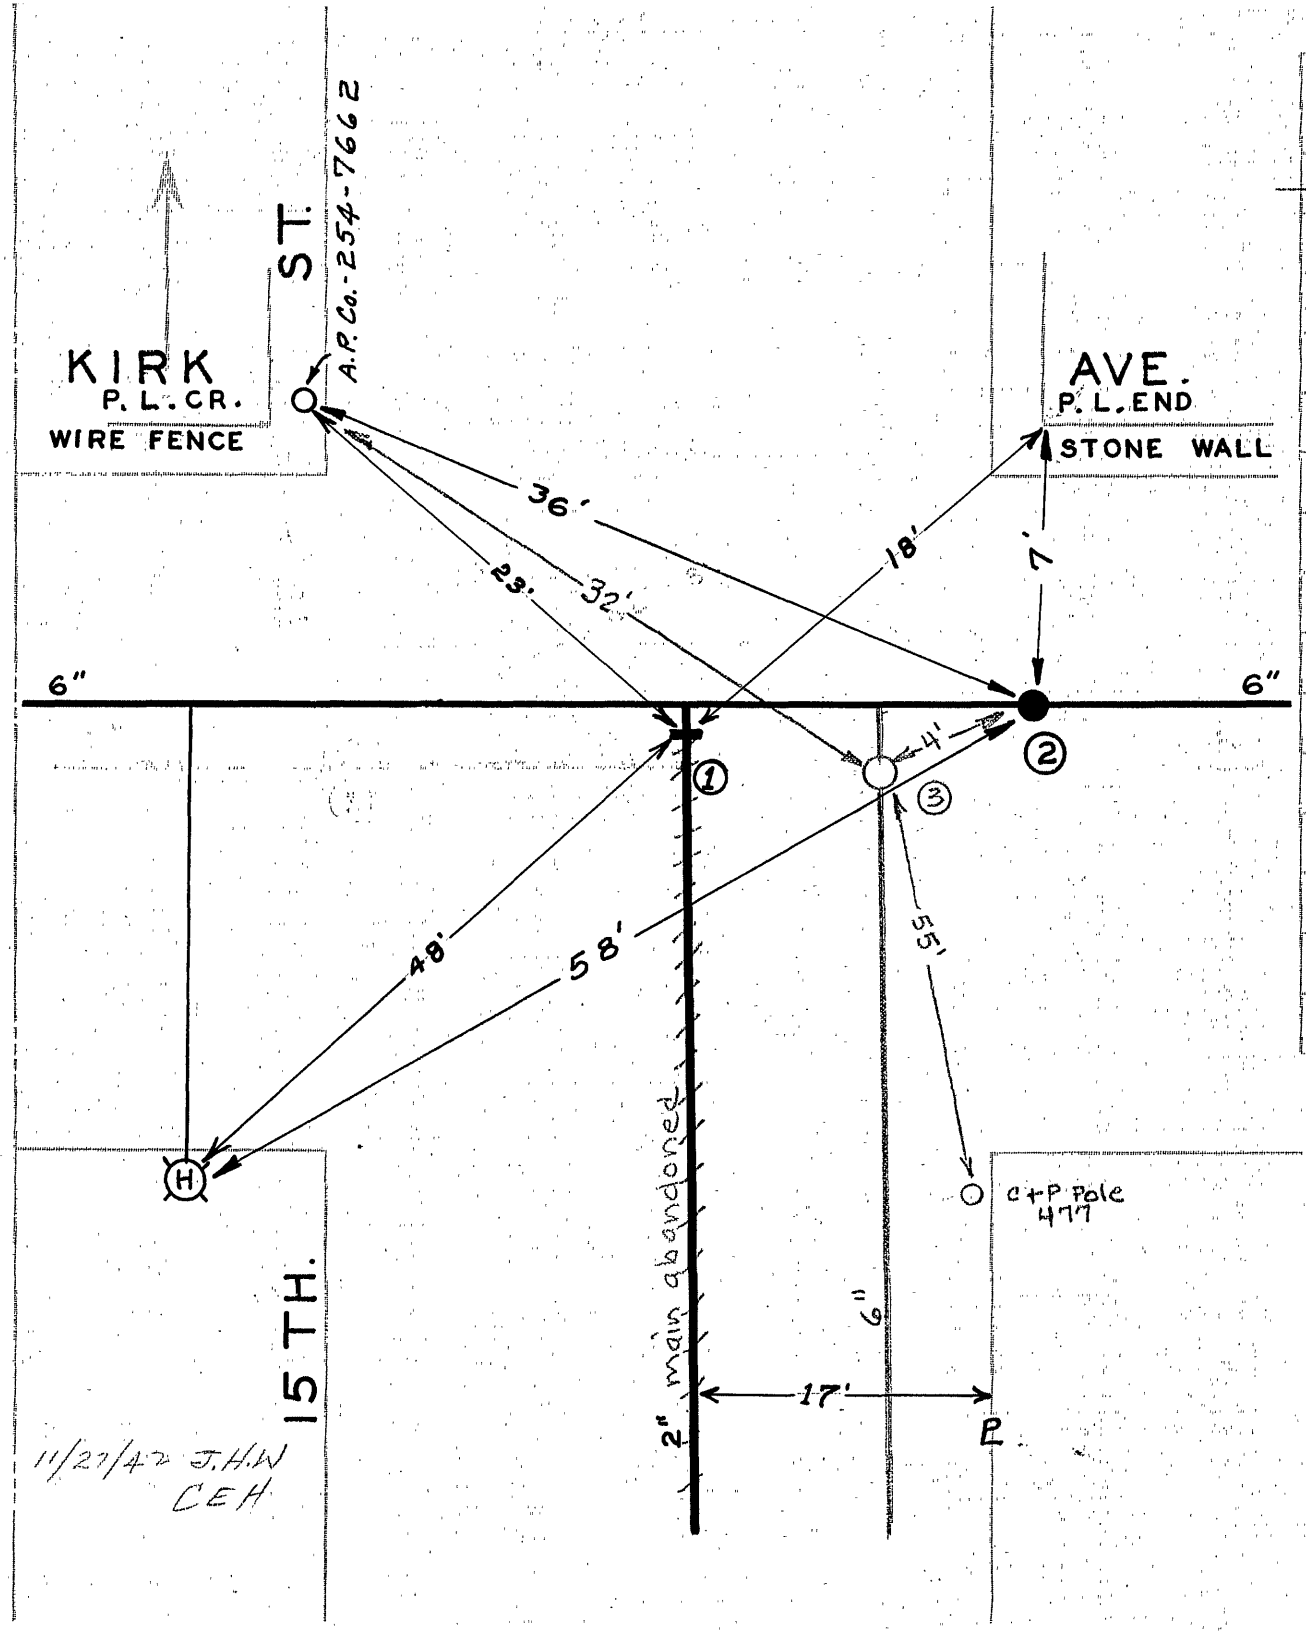

DATE	NO.	SIZE	MAKE	OPEN	TURNS
~~'60~~	~~1~~	~~2"~~	~~MISC~~	~~L~~	
1958	2	6"	MUELLER	R	21
1996	3	6"	Mueller	R	21
	1	36'N	SPL		
	2	0	EPL		

CITY OF ROANOKE — WATER DEP'T

VALVE DIAGRAM

KIRK AVE. & 15TH. ST. S. E.

SEC. MAP 421

DATE

PAGE NO. S.E.203