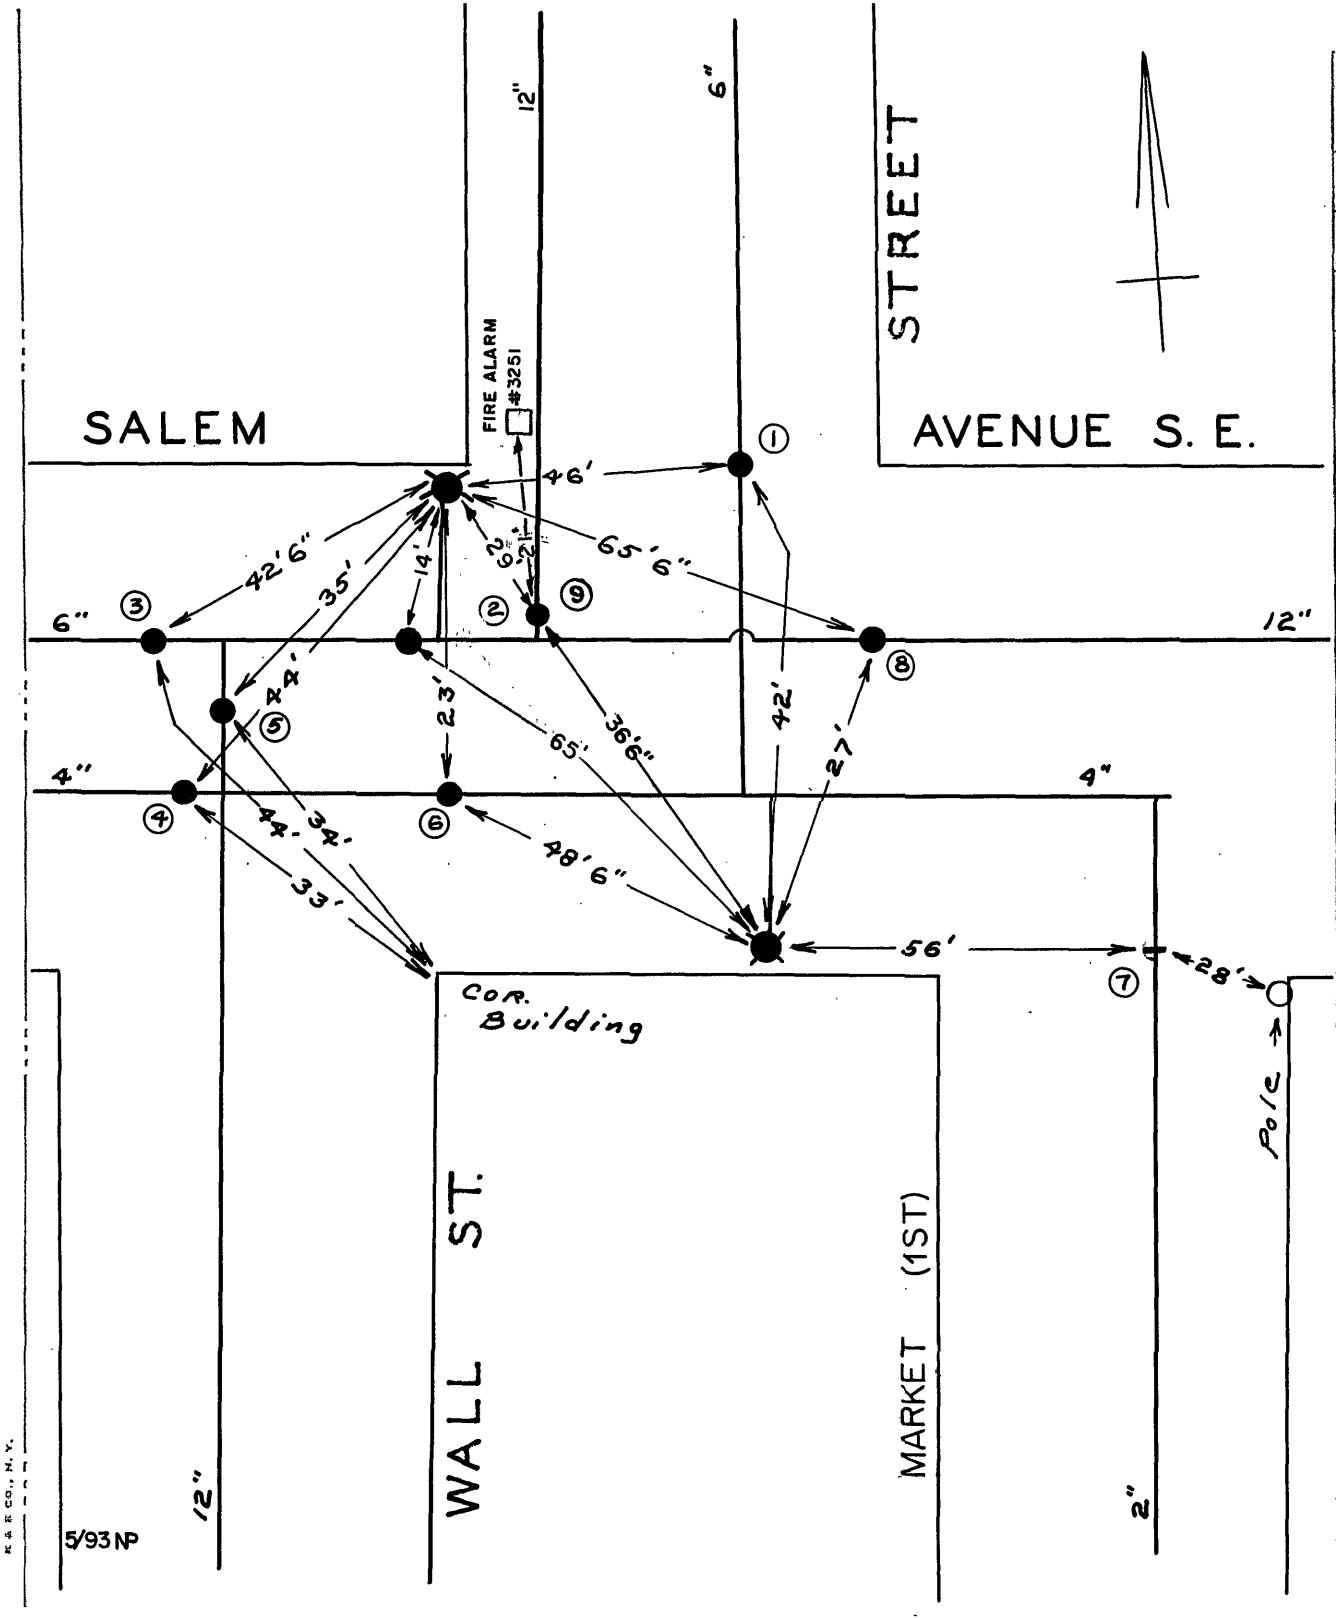

DATE	NO.	SIZE	MAKE	OPEN	TURNS
1892	1	6"			
1955	2	12"			
1899	3	6"			
1889	4	4"			
1922	5	12"			
1889	6	4"			
1922	7	2"			
1955	8	12"			
1990	9	12"	KENNEDY	R	39
	2	0	EPL		
	3	31'-W	EPL		
	4	28'-W	EPL		
	5	28'-N	SPL		
	6	2'-W	WPL		
	7	3'-N	SPL		
	8	0	EPL		
	1	0	NPL		

CITY OF ROANOKE—WATER DEPT.

VALVE DIAGRAM

SALEM AVE.

WALL ST.

(1ST) MARKET ST.

SEC. MAP 401 S.E.

DATE PAGE NO.

"IMPERIAL" TRACING CLOTH. K & E CO., N. Y.