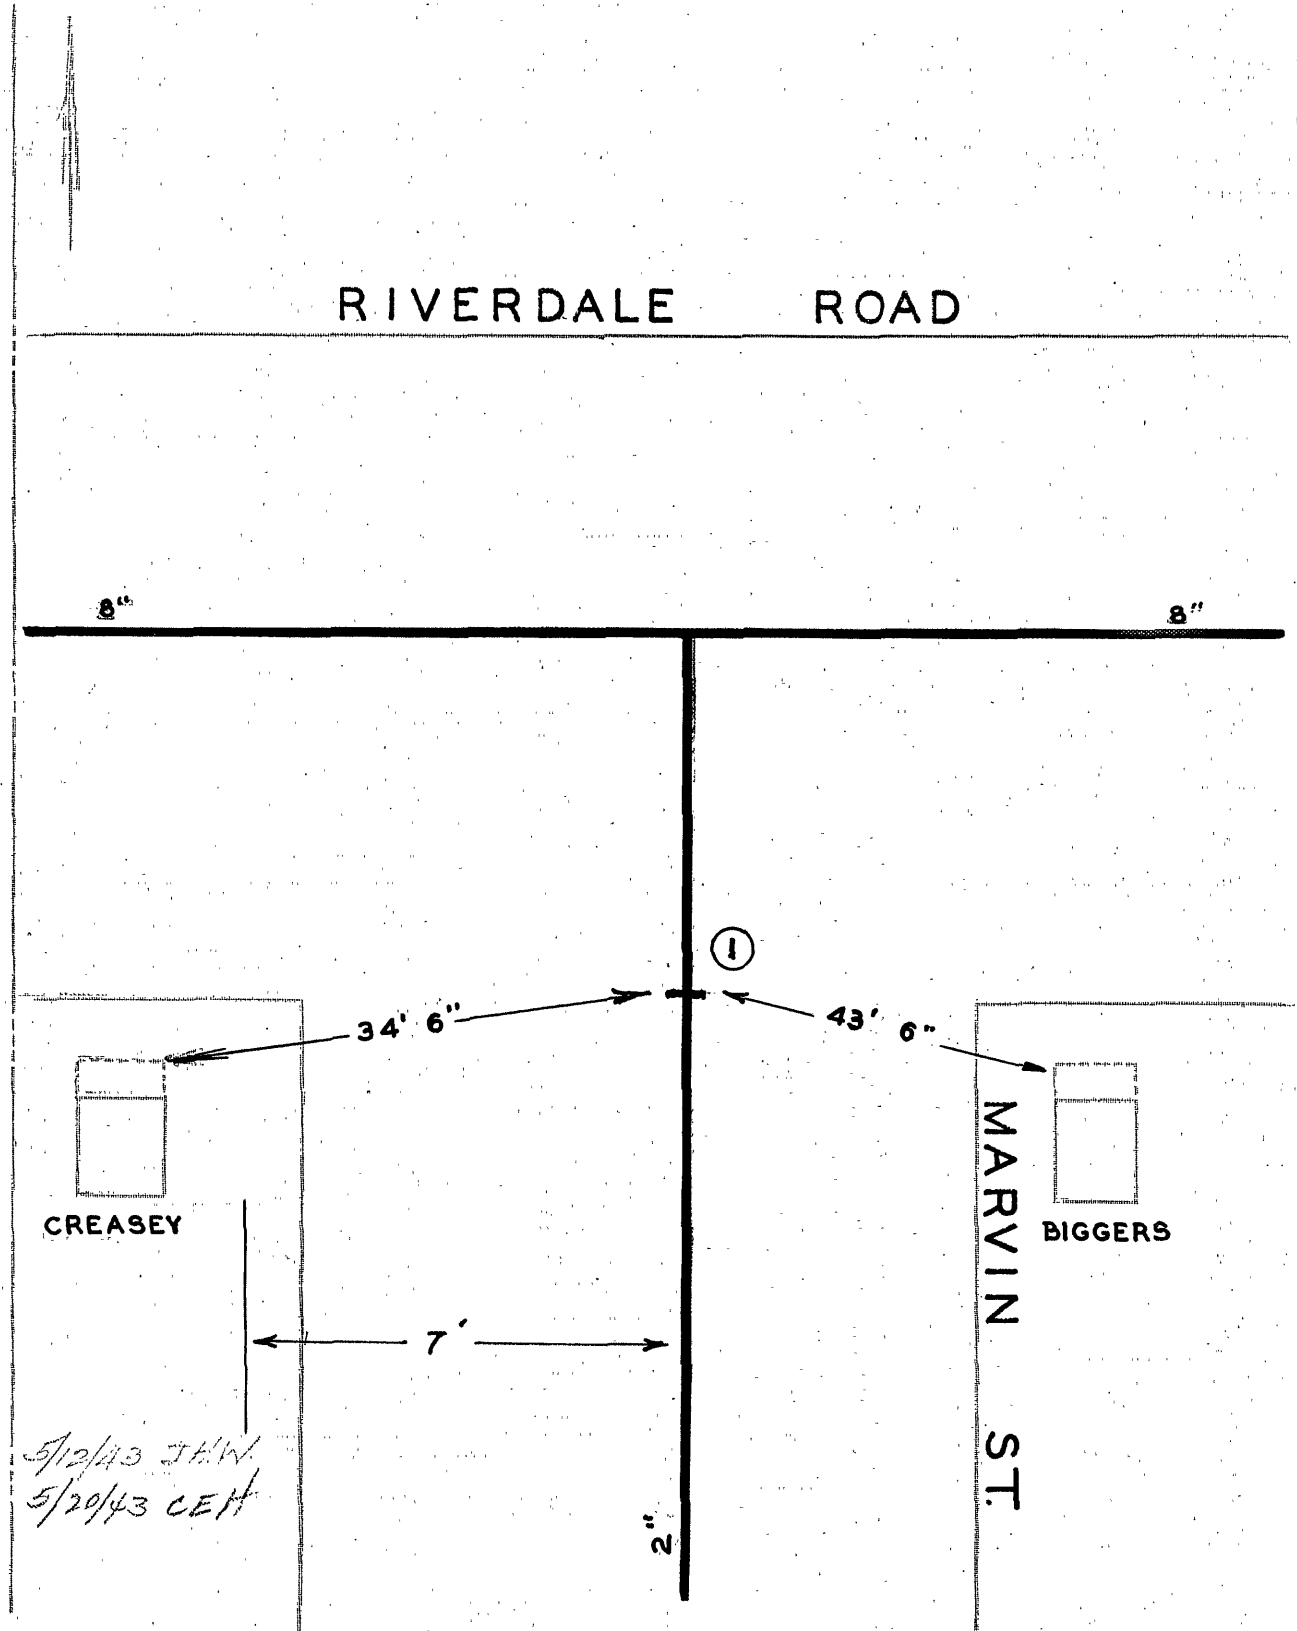

DATE	NO.	SIZE	MAKE	OPEN	TURNS
1940	1	2"	/	R	7
	1	0	SPL		

CITY OF ROANOKE—WATER DEPT

VALVE DIAGRAM

MARVIN STREET &

RIVERDALE ROAD S.E.

SEC. MAP 443

DATE PAGE NO. S.E. 99