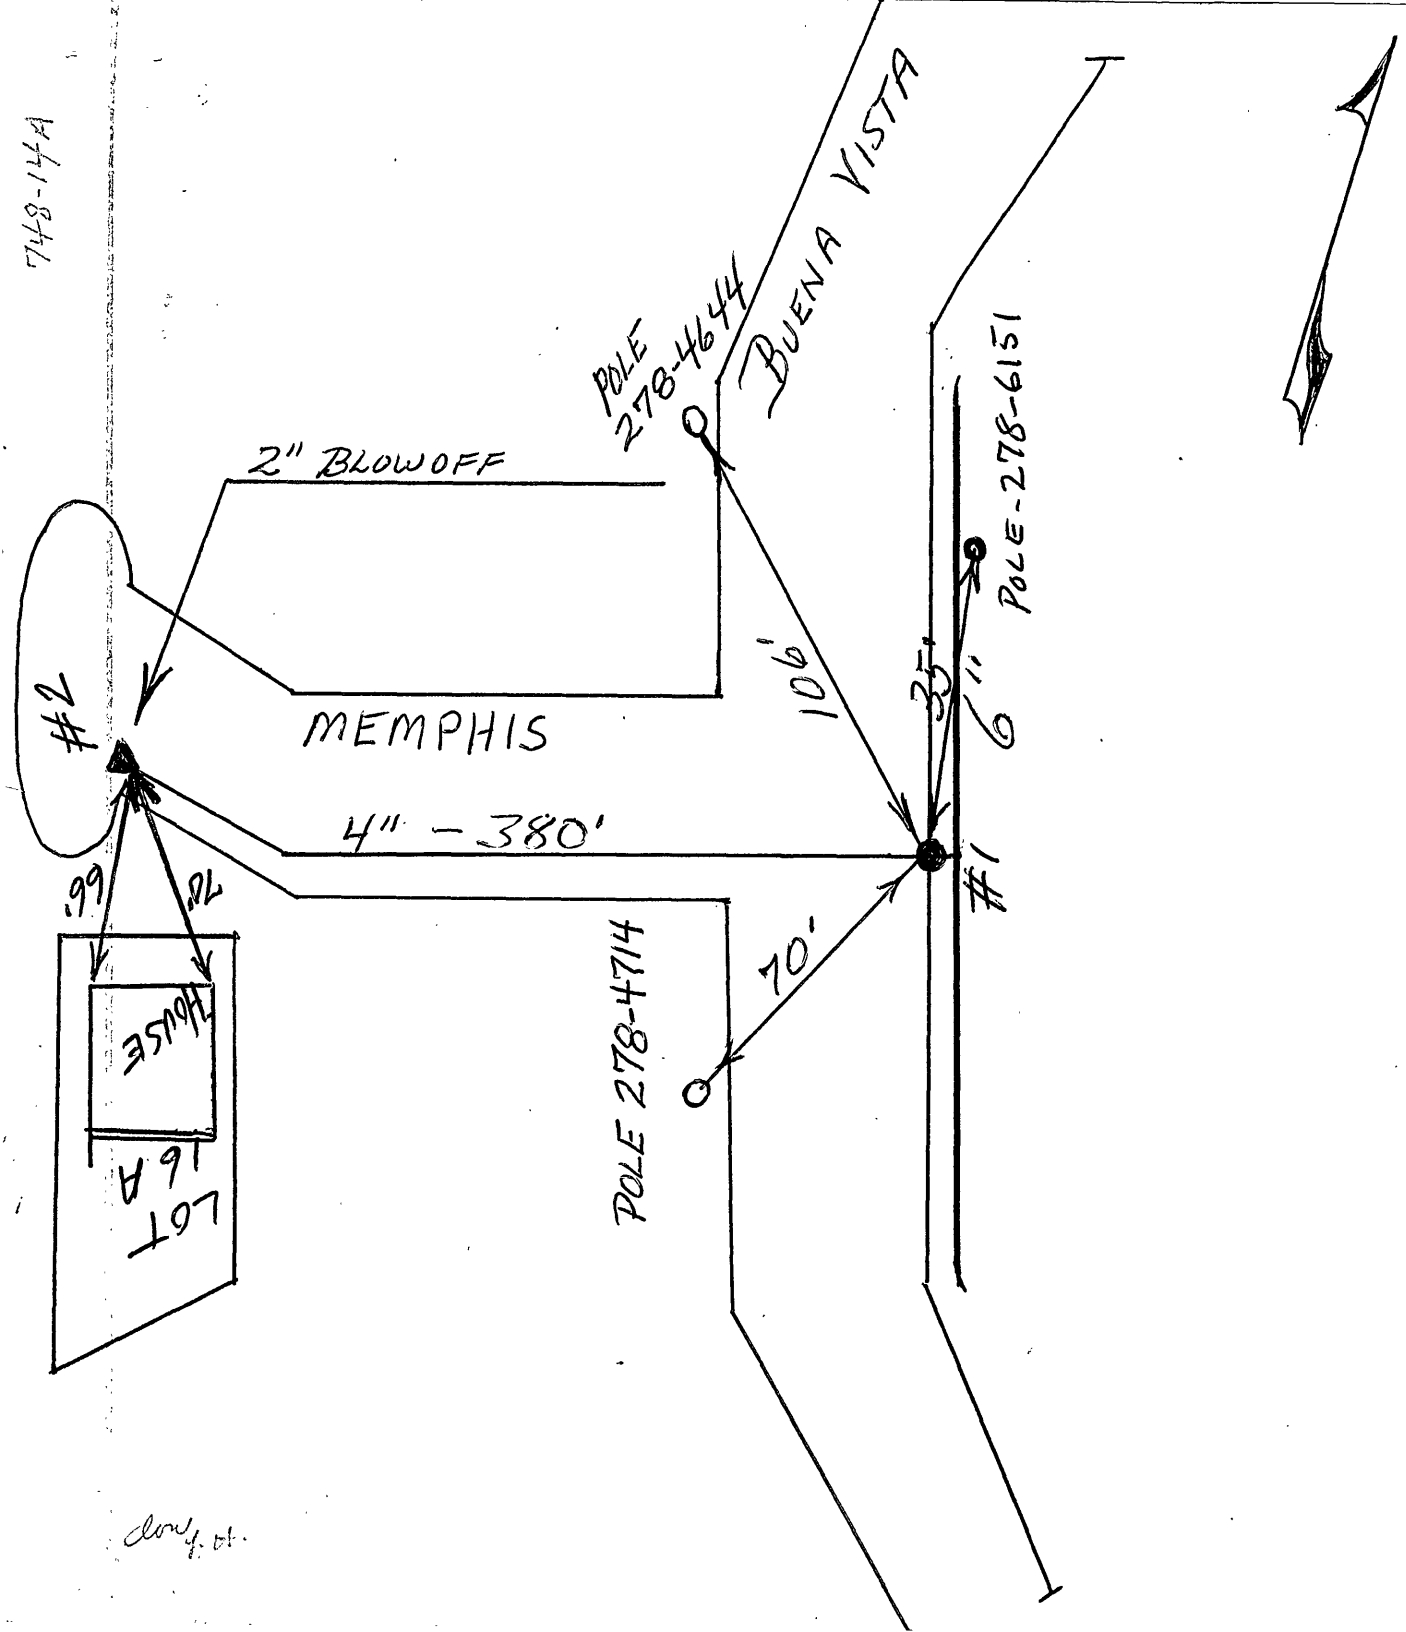

DATE	NO.	SIZE	NAME	OPEN	TURNS
1-85	1	4"	TAPPING MUELLER	R	
1-85	2	2"	MISC:	L	

VALVE DIAGRAM

MEMPHIS ST @ BUENA VISTA

SEC. NO. 414

DATE 5-85 PAGE NO.

748-174