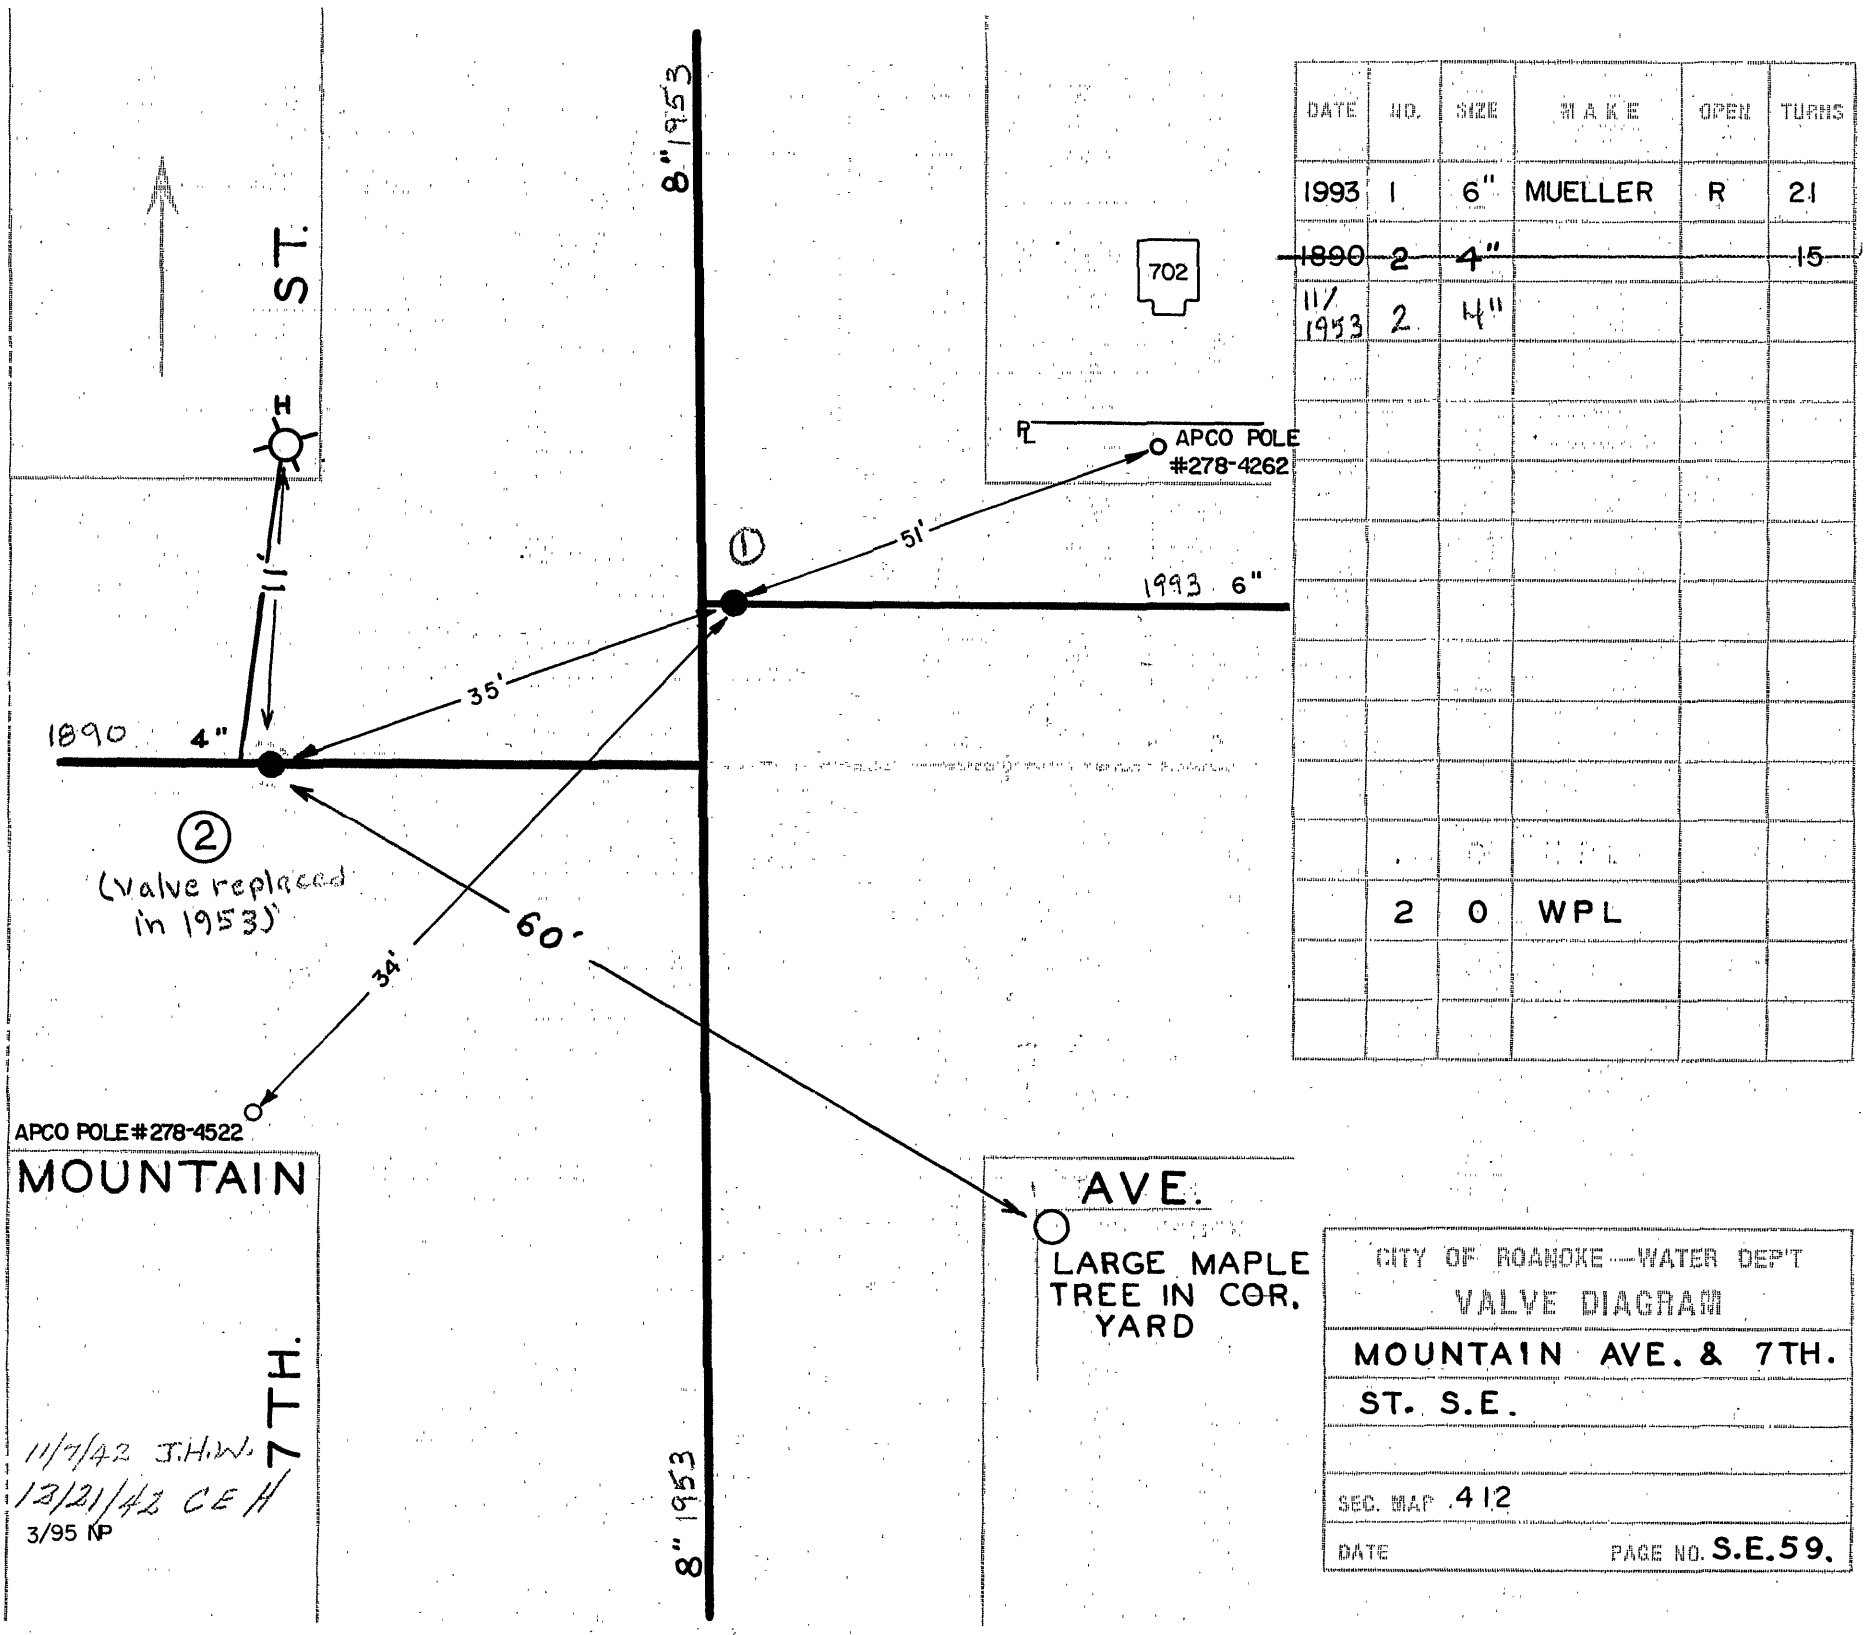

DATE	NO.	SIZE	MAKE	OPEN	TURNS
1993	1	6"	MUELLER	R	21
~~1890~~	~~2~~	~~4"~~			~~15~~
11/ 1953	2	4"			
	2	0	WPL		

CITY OF ROANOKE — WATER DEP'T

VALVE DIAGRAM

MOUNTAIN AVE. & 7TH. ST. S.E.

SEC. MAP 412

DATE

PAGE NO. S.E.59.