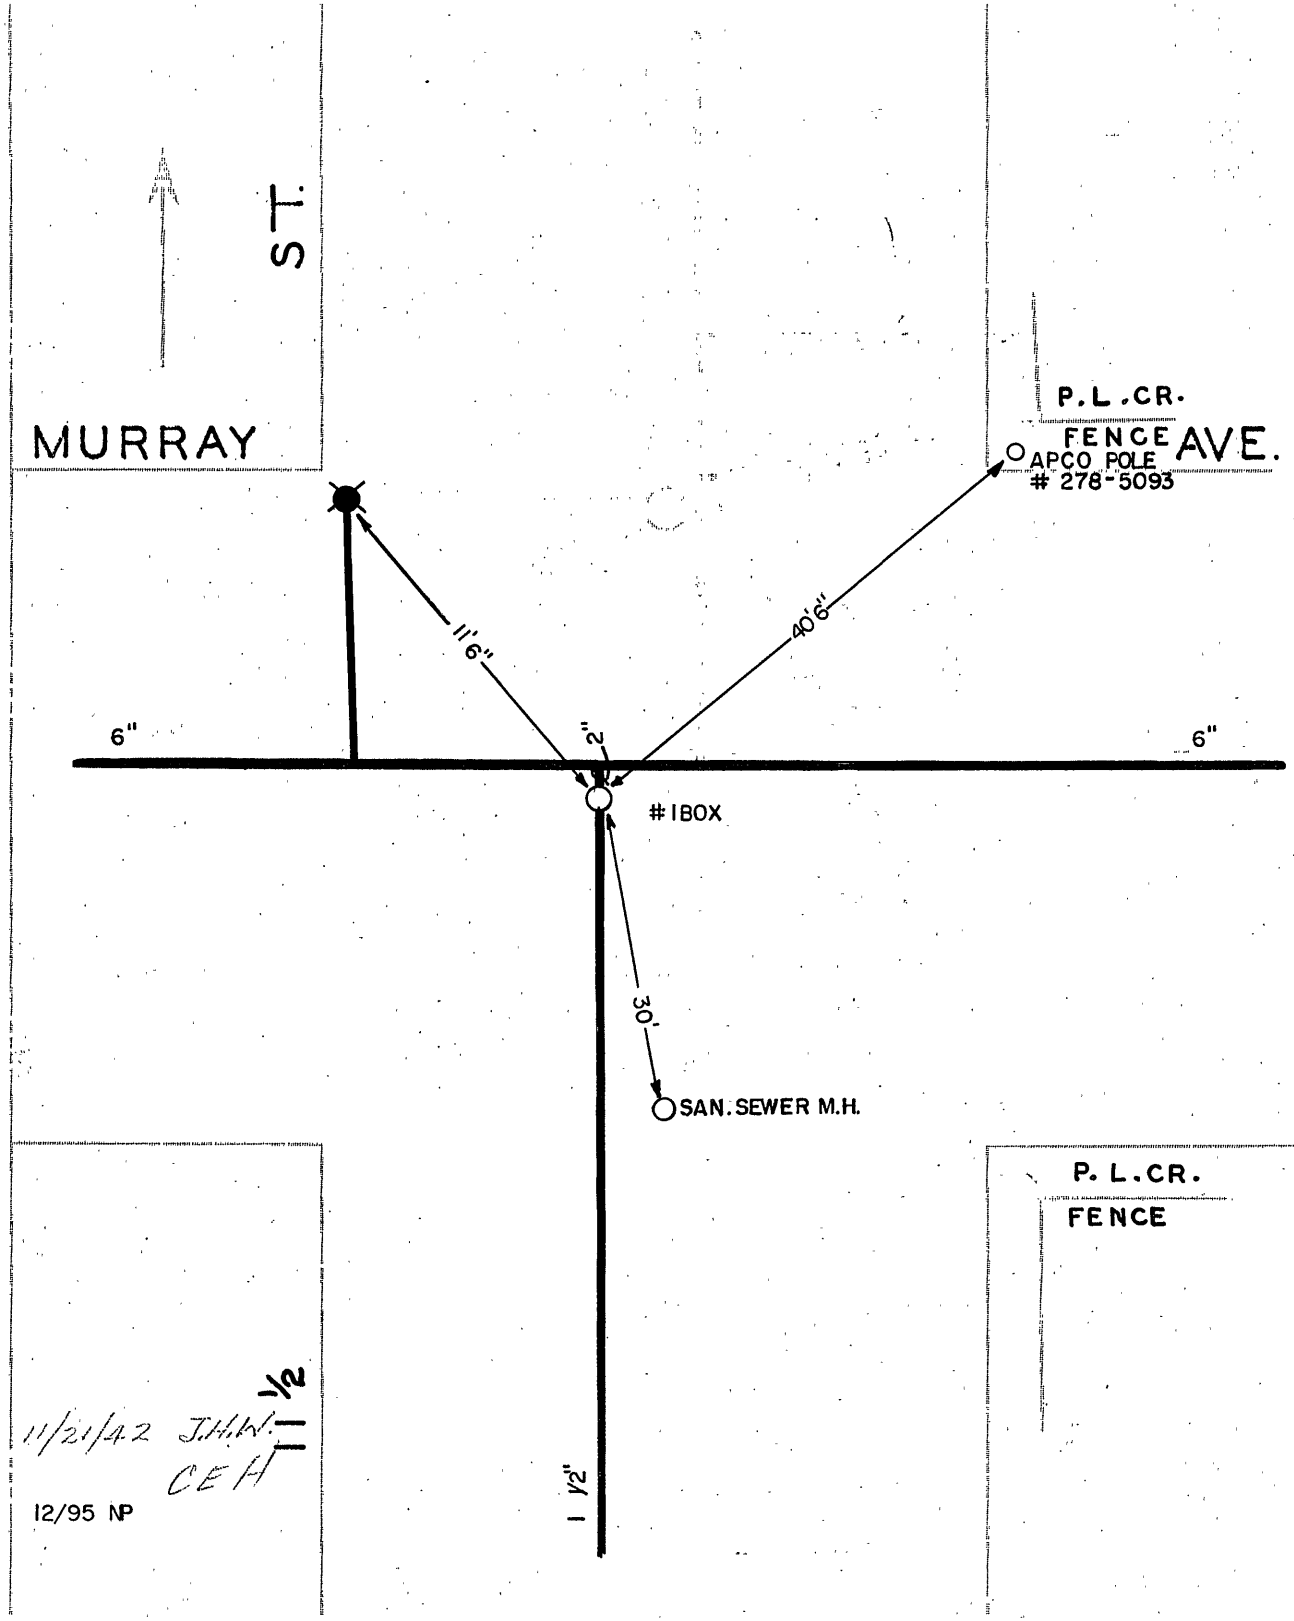

DATE	NO.	SIZE	MAKE	OPEN	TURNS
1995	1	2 1/2	MISCELLAN.	L	9

CITY OF ROANOKE—WATER DEP'T

VALVE DIAGRAM

MURRAY AVE. & 111/2. ST. S.E.

SEC. MAP 412

DATE

PAGE NO. S.E.146