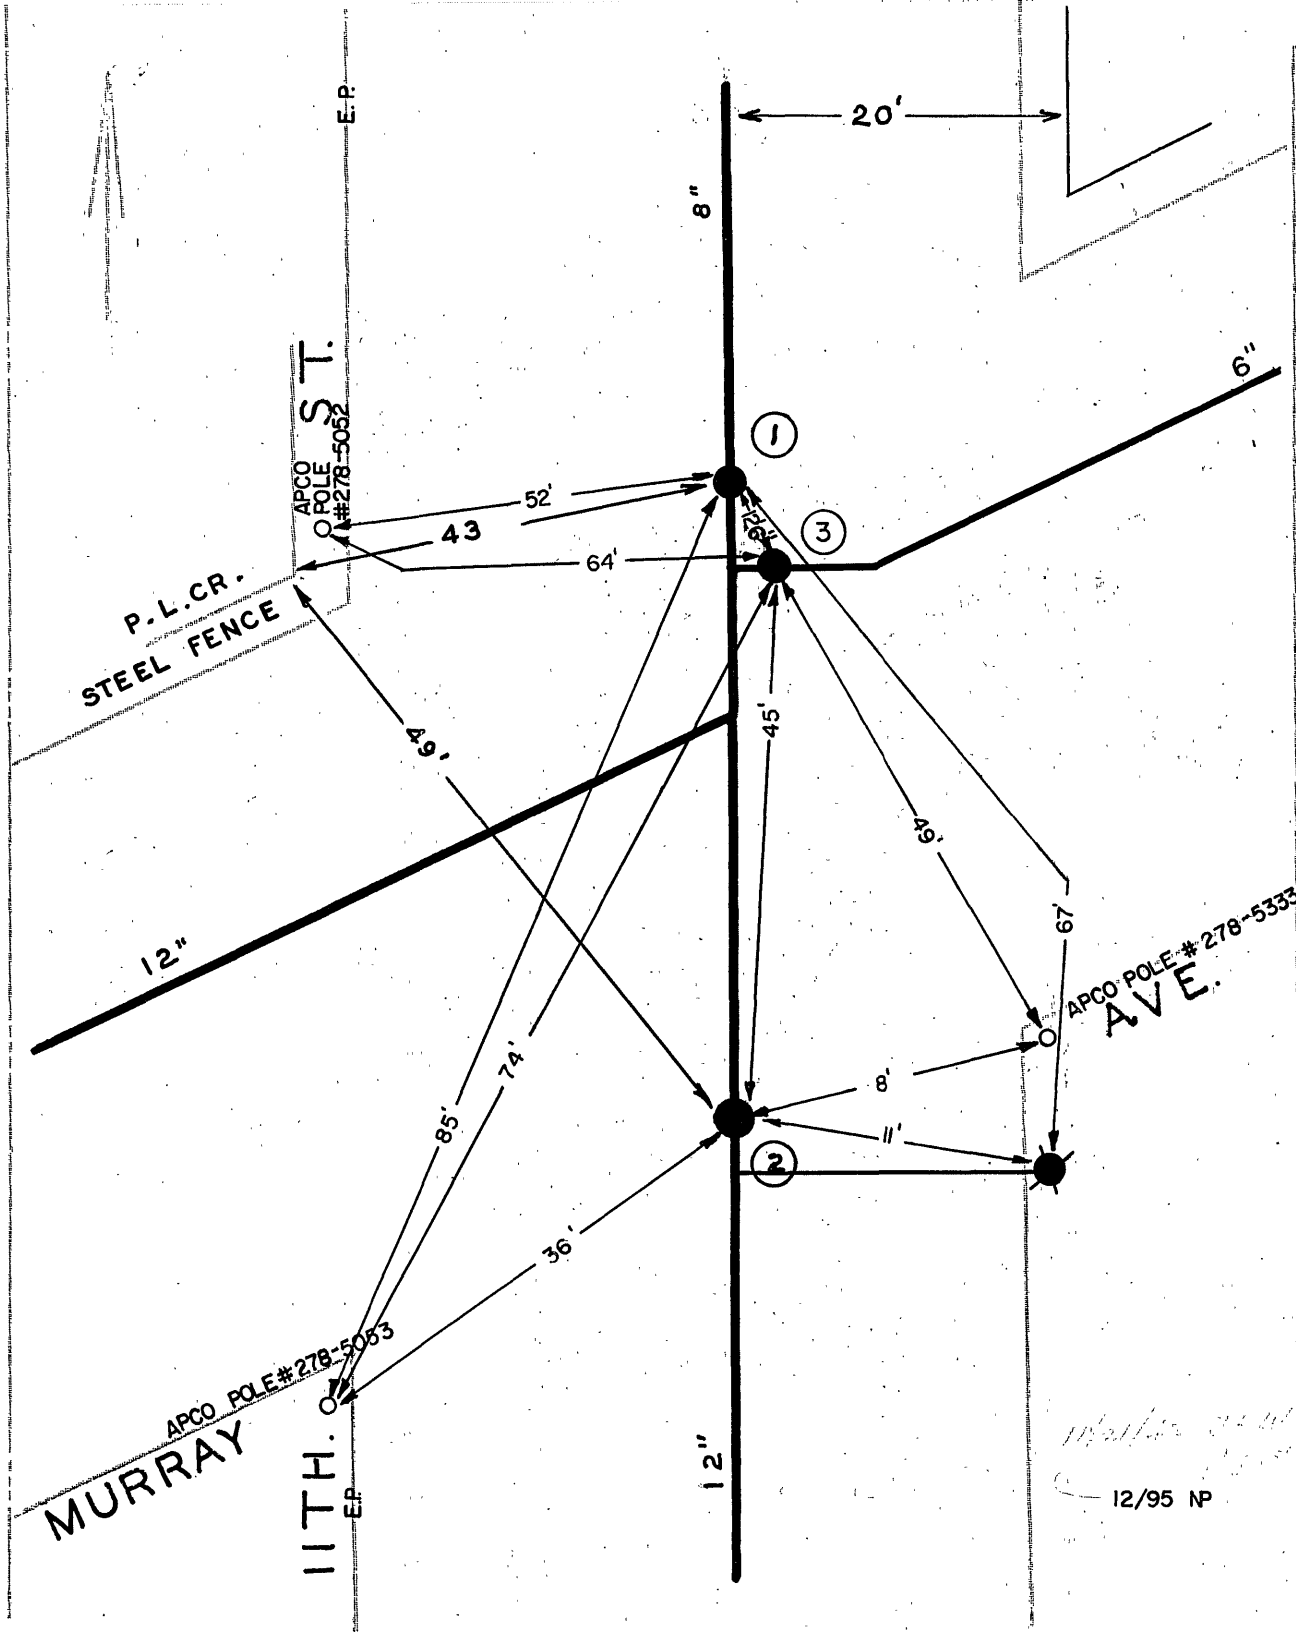

DATE	NO.	SIZE	MAKE	OPEN	TURNS
1941	1	8"		R	27
1925	2	12		R	39
1994	3	6"	MUELLER	R	21
	1	0	NPL		
	2	0	SPL		

CITY OF ROANOKE—WATER DEP'T

VALVE DIAGRAM

MURRAY AVE. & 11TH. ST. S.E.

SEC. MAP 412

DATE

PAGE NO S.E.144