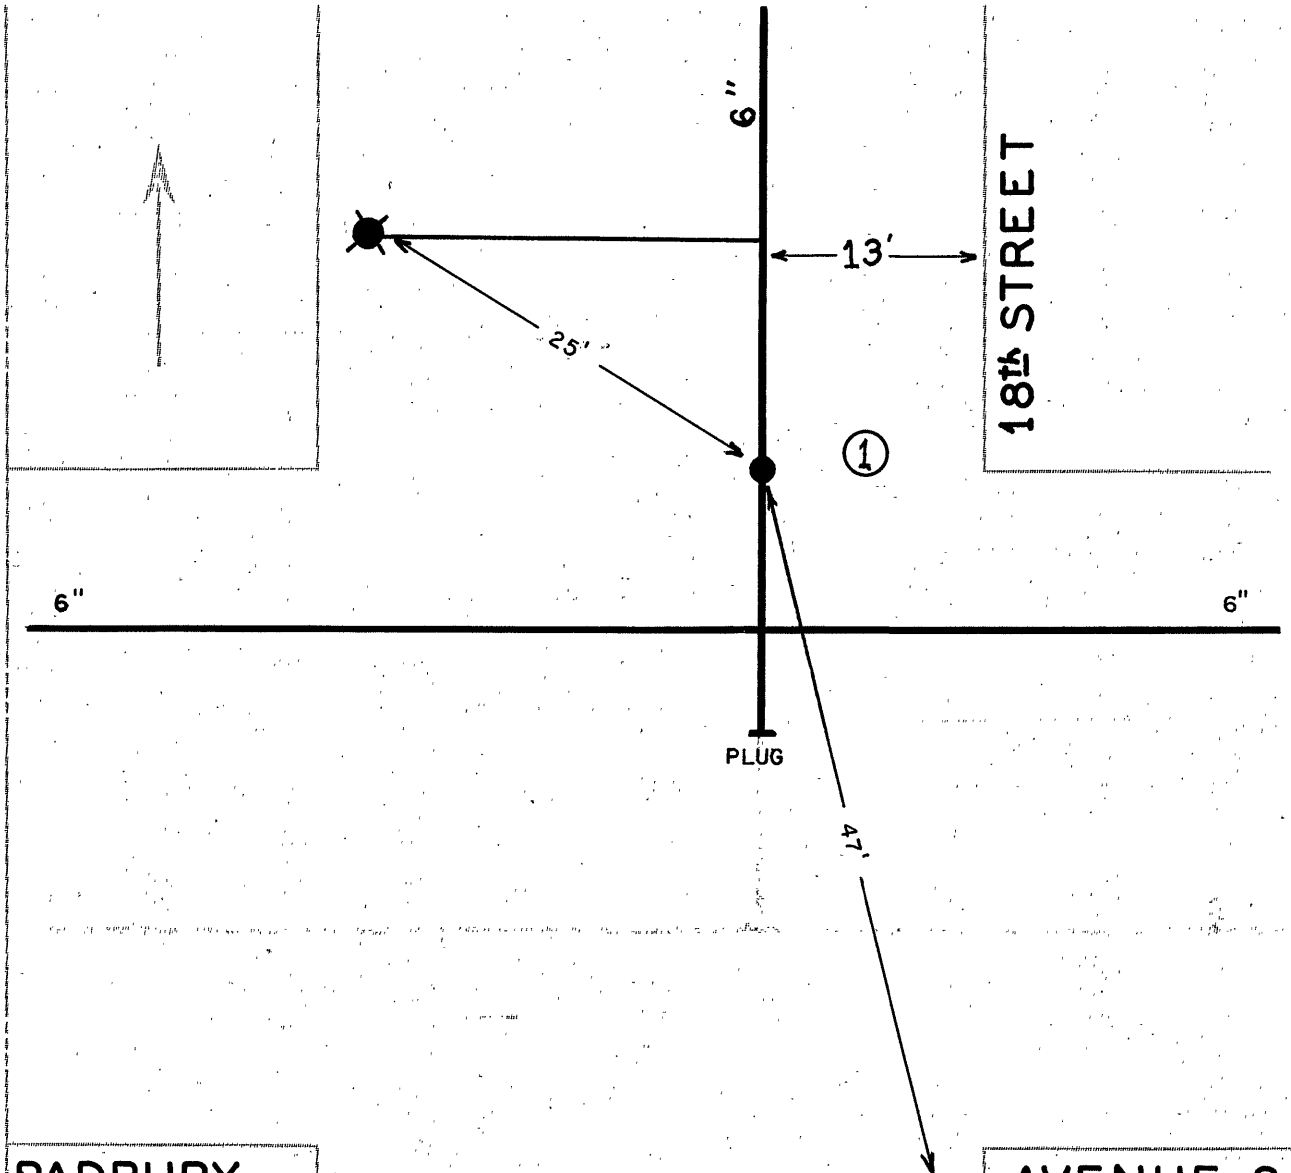

DATE	NO.	SIZE	MAKE	OPEN	TURNS
4-92	1	6"	DARLING	R	21
	1	0	NPL		

PADBURY

AVENUE S. E.

APCO POLE #279-1105

8/93 NP

CITY OF ROANOKE — WATER DEPT

VALVE DIAGRAM

PADBURY AVENUE & 18th STREET S.E.

SEC. MAP 444

DATE PAGE NO.