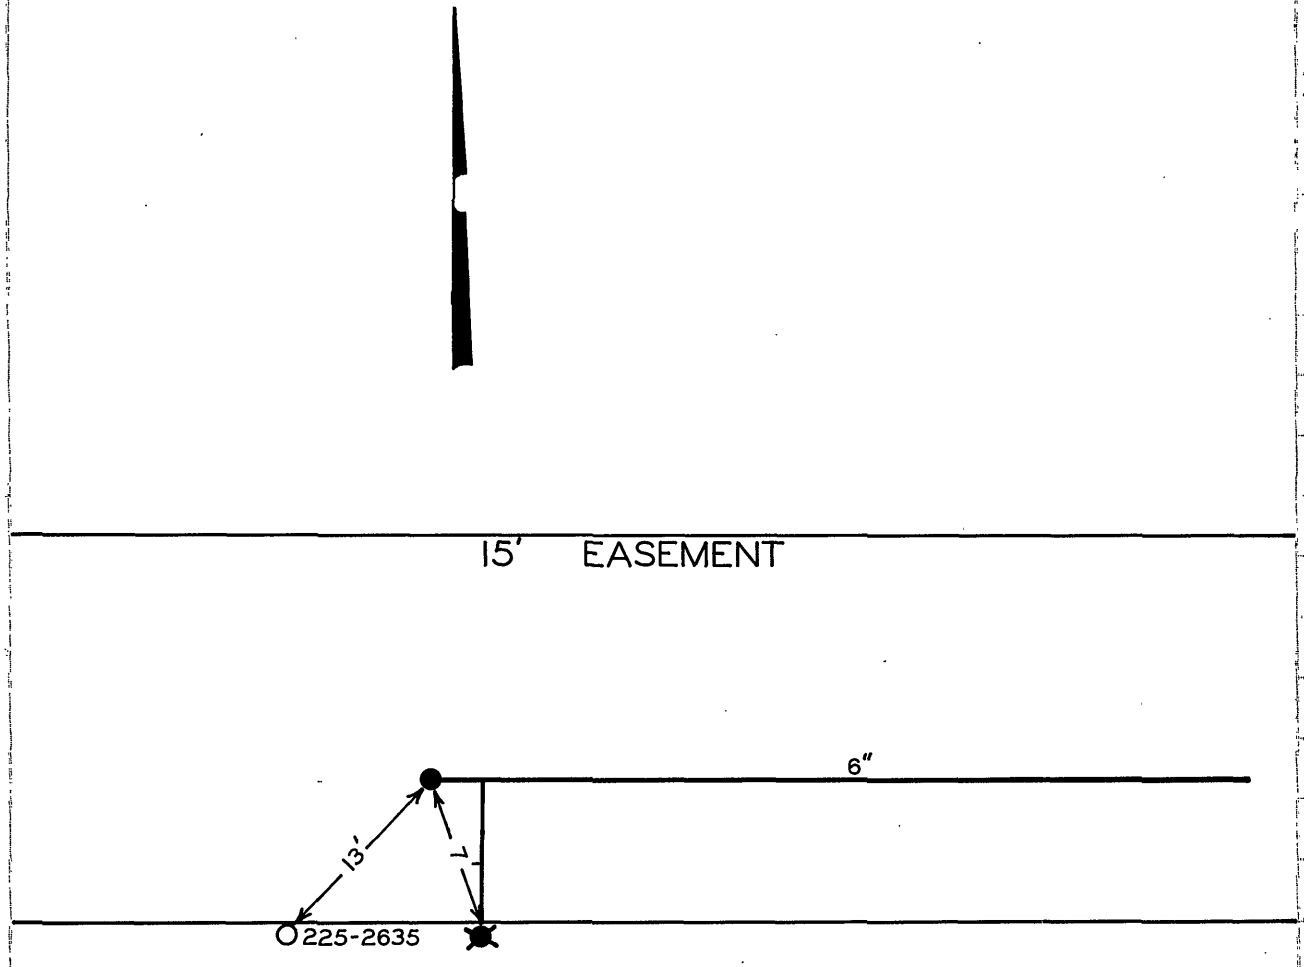

DATE	NO.	SIZE	MAKE	OPEN	TURNS
7-71	1	2"	MISC.	R	

CITY OF ROANOKE—WATER DEPT
VALVE DIAGRAM

PARKSIDE PLAZA - 605' WEST OF VERNON STREET S.E.

SEC. NO. 431

DATE PAGE NO.