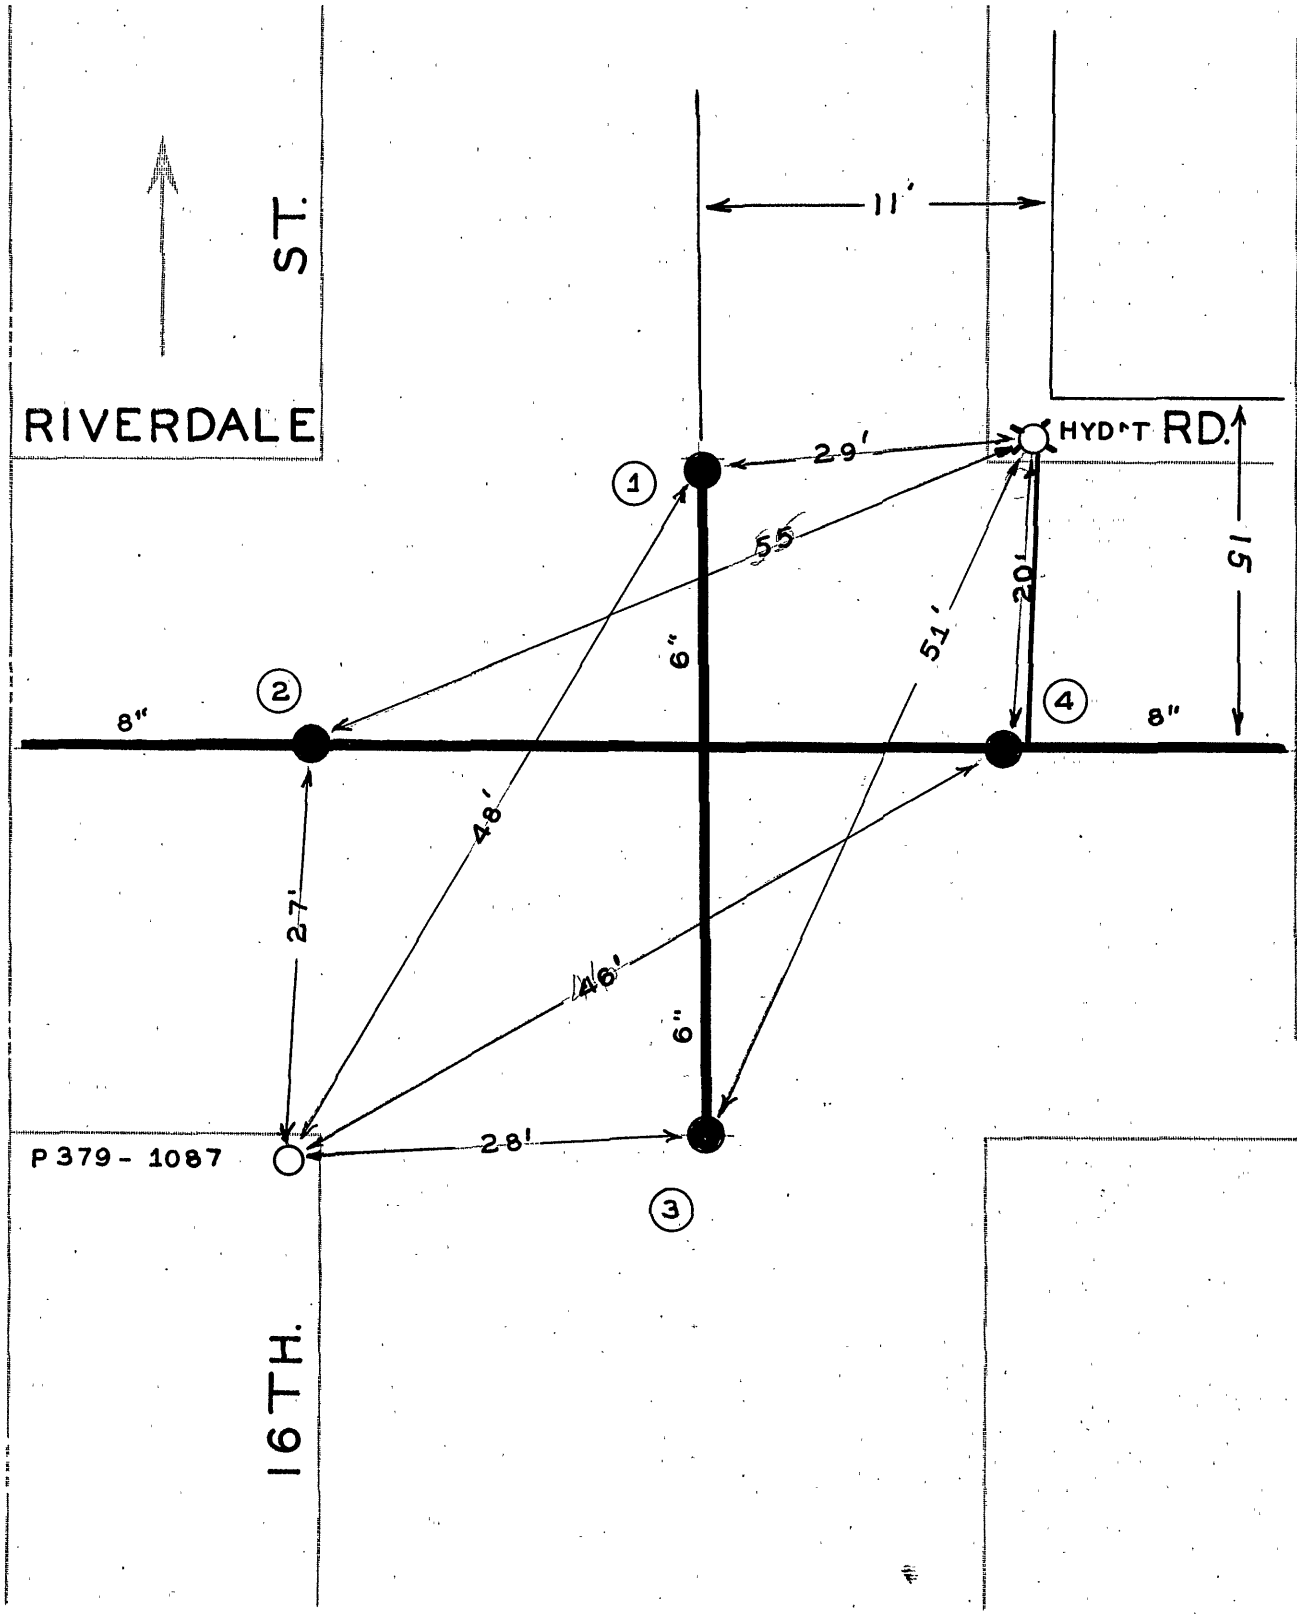

DATE	NO.	SIZE	MAKE	OPEN	TURNS
1949	1	6"	DARLING	R	21
1949	2	8"	DARLING	R	27
1949	3	6"	DARLING	R	21
1949	4	8"	DARLING	R	27
	1	0	NPL		
	2	0	WPL		
	3	0	SPL		
	4	0	EPL		

CITY OF ROANOKE—WATER DEP'T

VALVE DIAGRAM

RIVERDALE ROAD &
16TH. STREET S.E.

SEC. MAP 434

DATE 10/24/49 PAGE NO. S E269