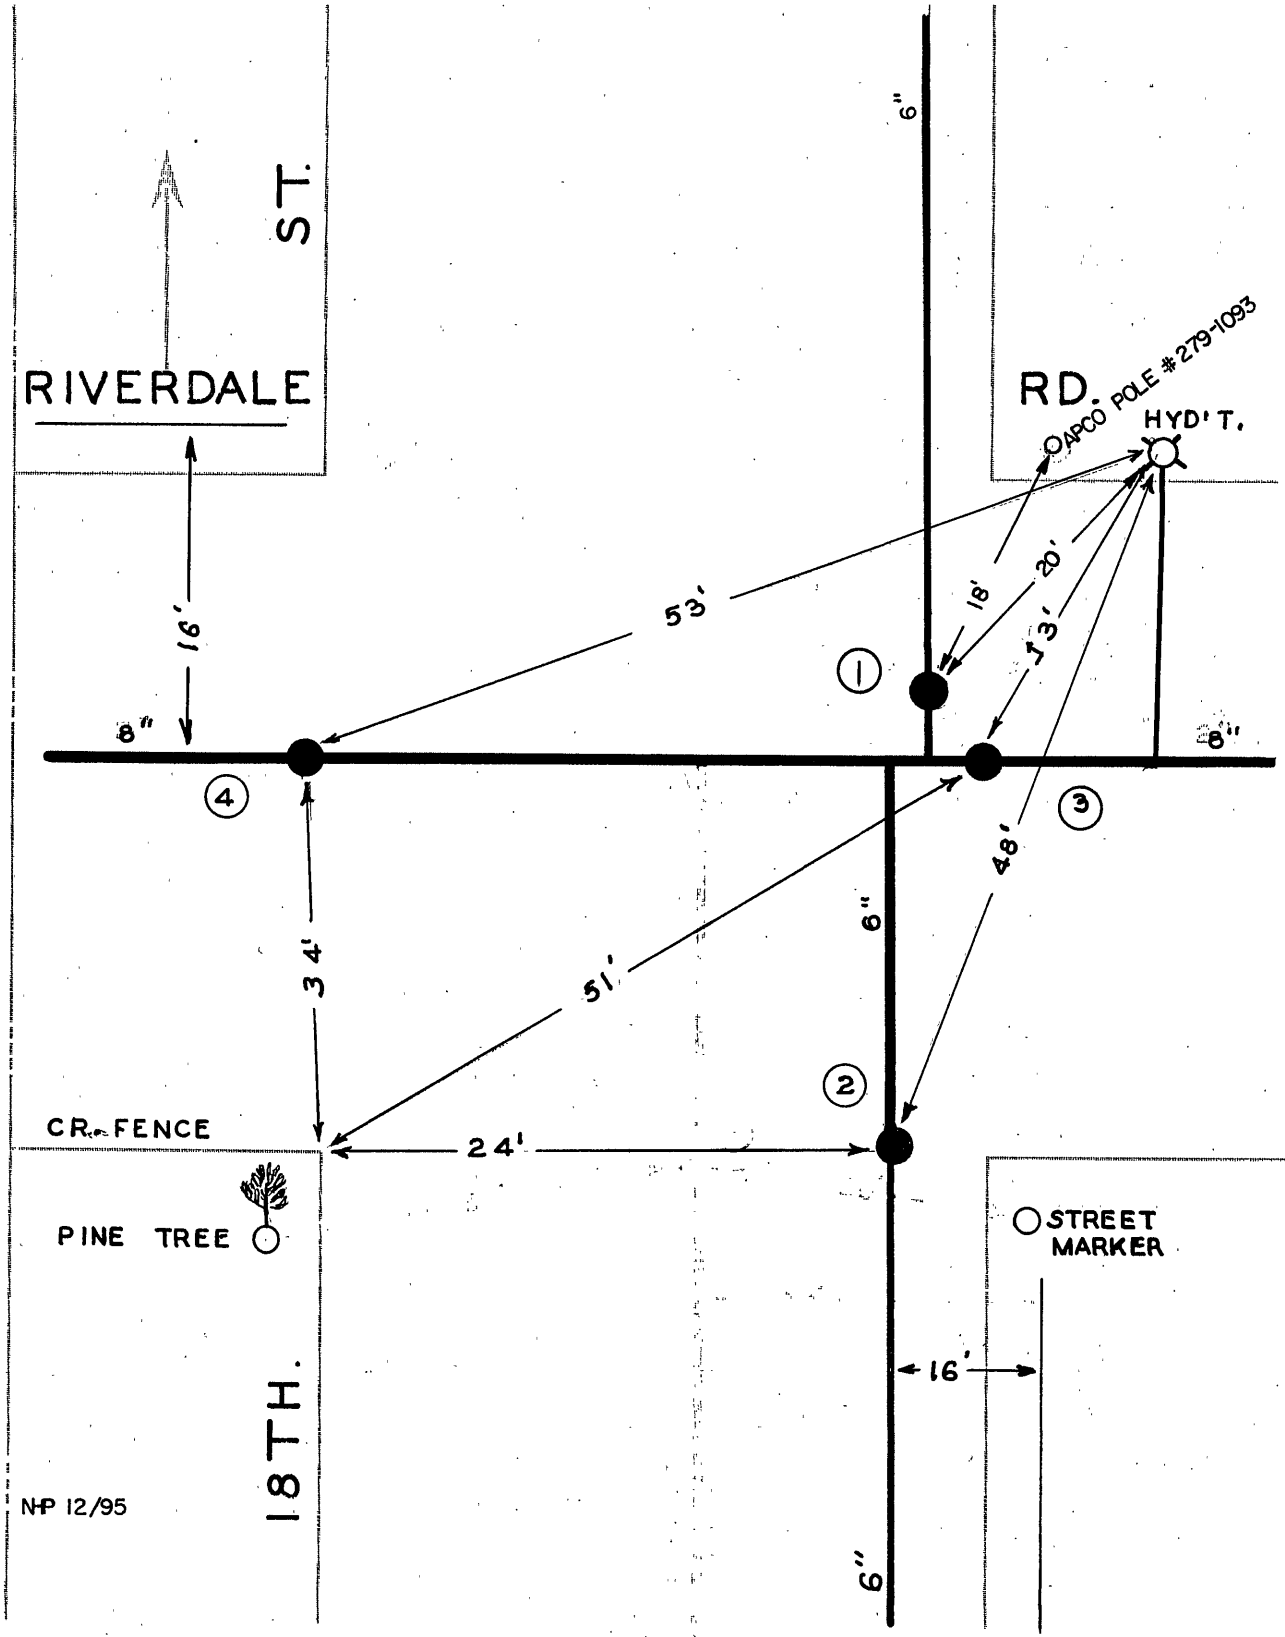

DATE	NO.	SIZE	MAKE	OPEN	TURNS
1994	1	6"	MUELLER	R	21
1949	2	6"	DARLING	R	21
1949	3	8"	DARLING	R	27
1949	4	8"	DARLING	R	27
	2	0	SPL		
	3	0	EPL		
	4	0	WPL		

CITY OF ROANOKE — WATER DEP'T

VALVE DIAGRAM

RIVERDALE ROAD &

18TH. STREET S.E.

SEC. MAP 443

DATE 2/27/47 PAGE NO S.E.265