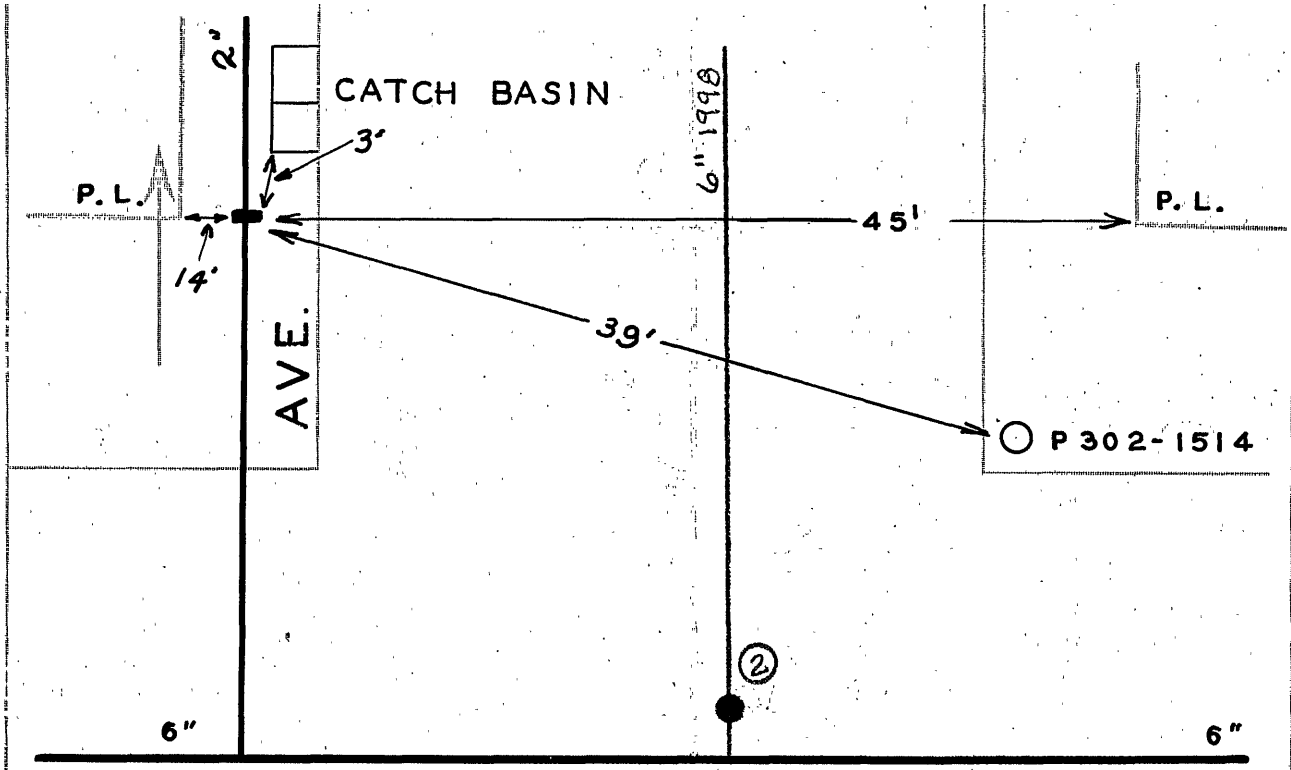

DATE	NO.	SIZE	MAKE	OPEN	TURNS
1924	1	2"		R	7
1998	2	6"			
	1	0	NPL		

26TH.

STANLEY

11/19/42 J.H.N.
12/22/42 CEH

ST.

CITY OF ROANOKE — WATER DEP'T
VALVE DIAGRAM
STANLEY AVE. & 26TH.
ST. SOUTH EAST
SEC. MAP 408
DATE
PAGE NO. S.W.222