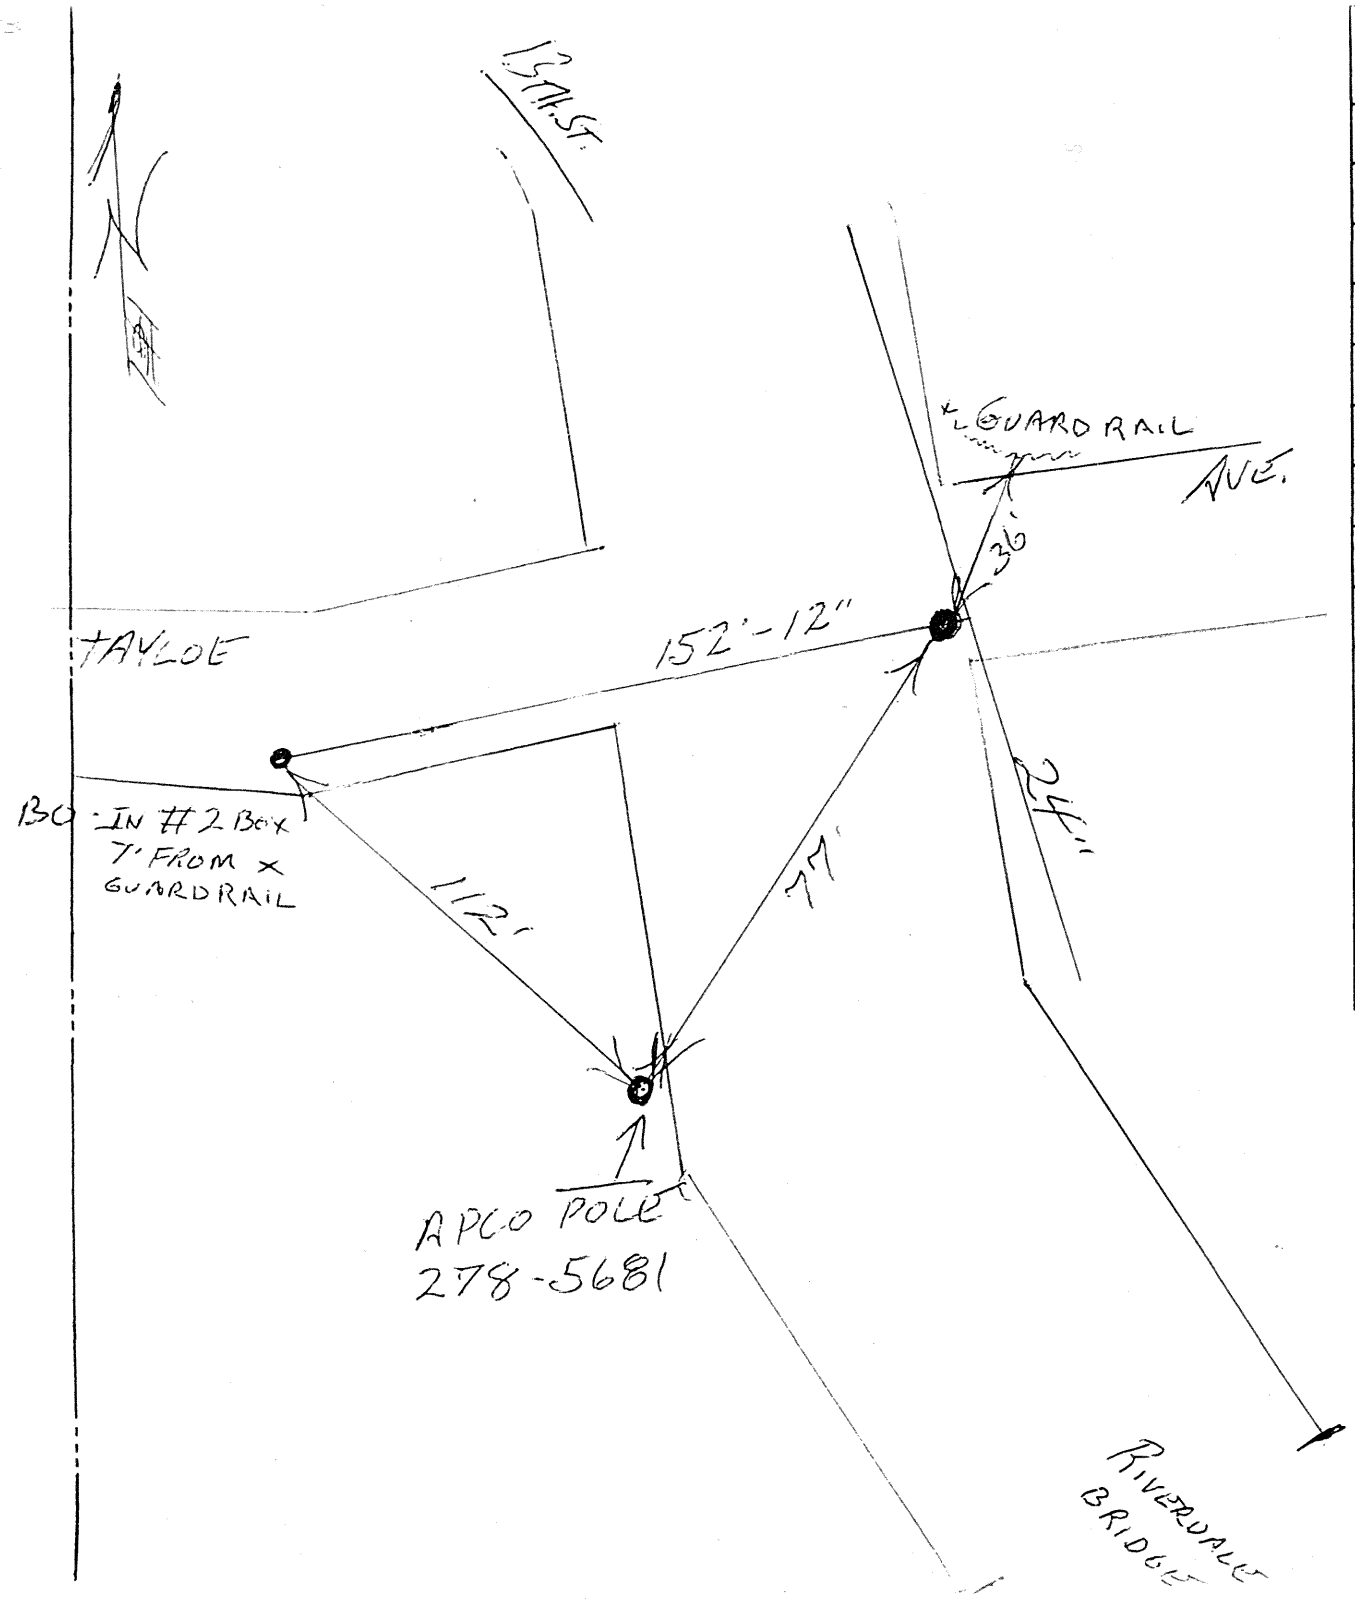

DATE	NO.	SIZE	MAKE	OPEN	TURNS
7-97	1	12	M	R	39
7-97	2	2"	MISC.	L	

CITY OF ROANOKE—WATER DEP'T

VALVE DIAGRAM

TAYLOE AVE & 13TH ST. SE

SEC. MAP

DATE PAGE NO.