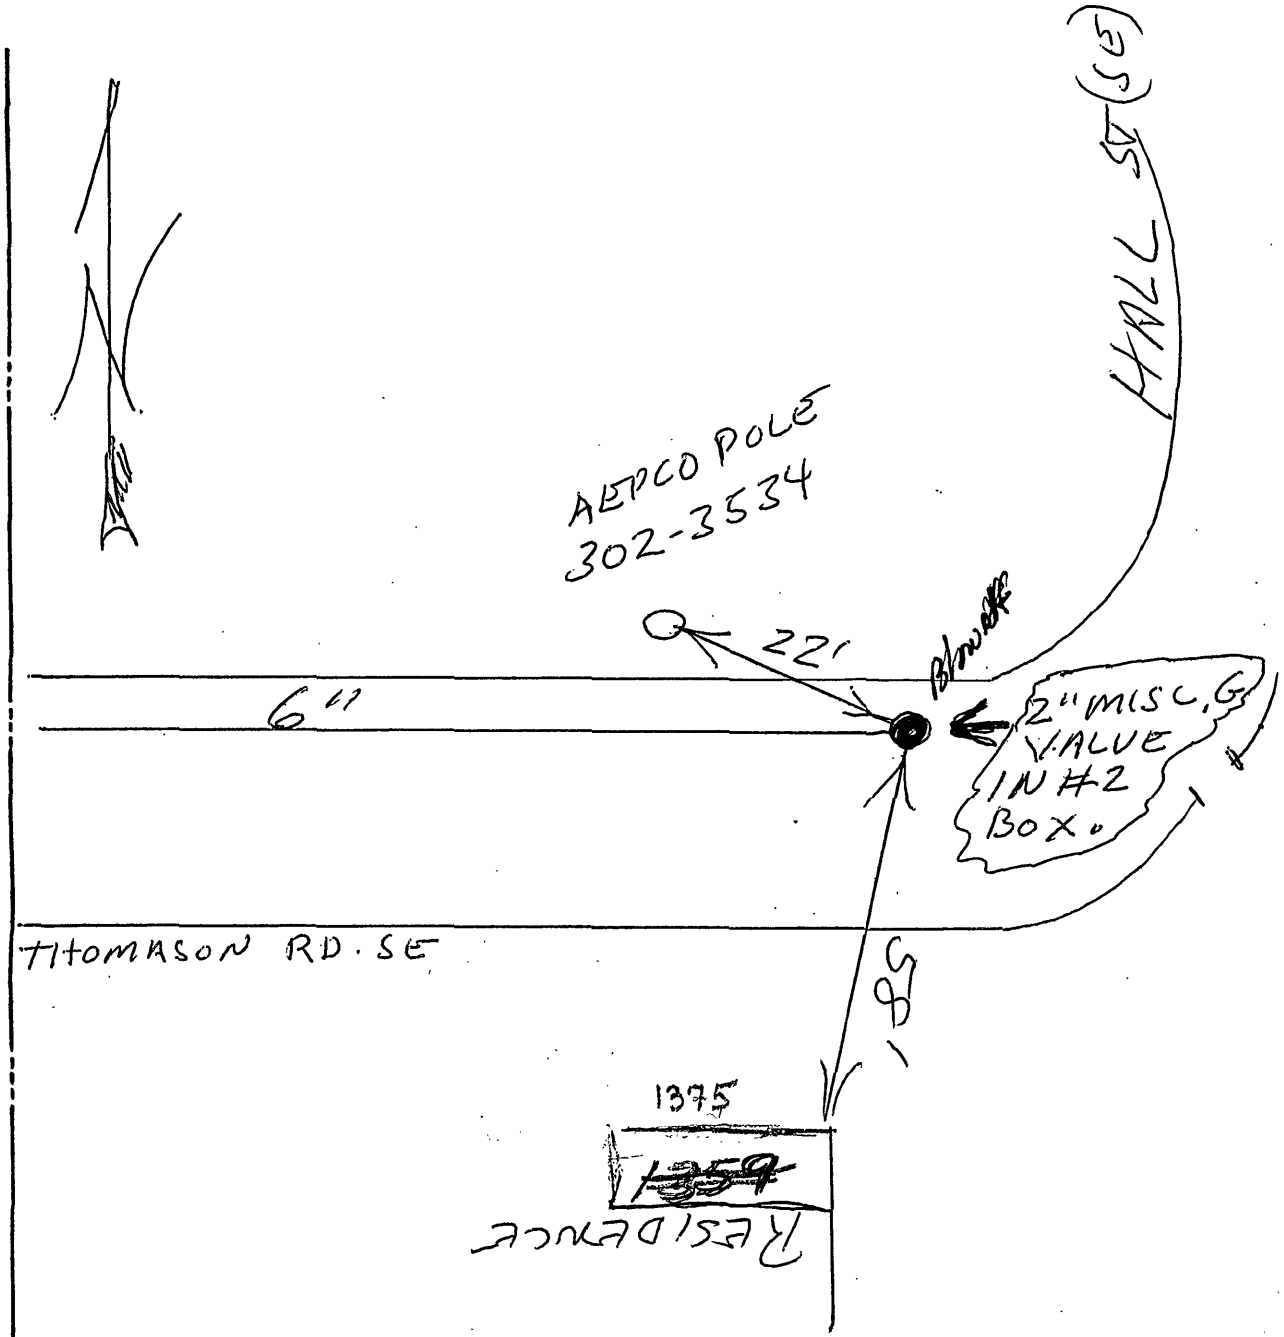

DATE	NO.	SIZE	MAKE	OPEN	TURNS
7-93	1	2	MISC	L	

CITY OF ROANOKE—WATER DEP'T

VALVE DIAGRAM

1375 (~~1358~~ 1359 ~~BLOCK~~) END

THOMASON RD. SE

AT HALL

SEC. MAP

DATE PAGE NO.

Done