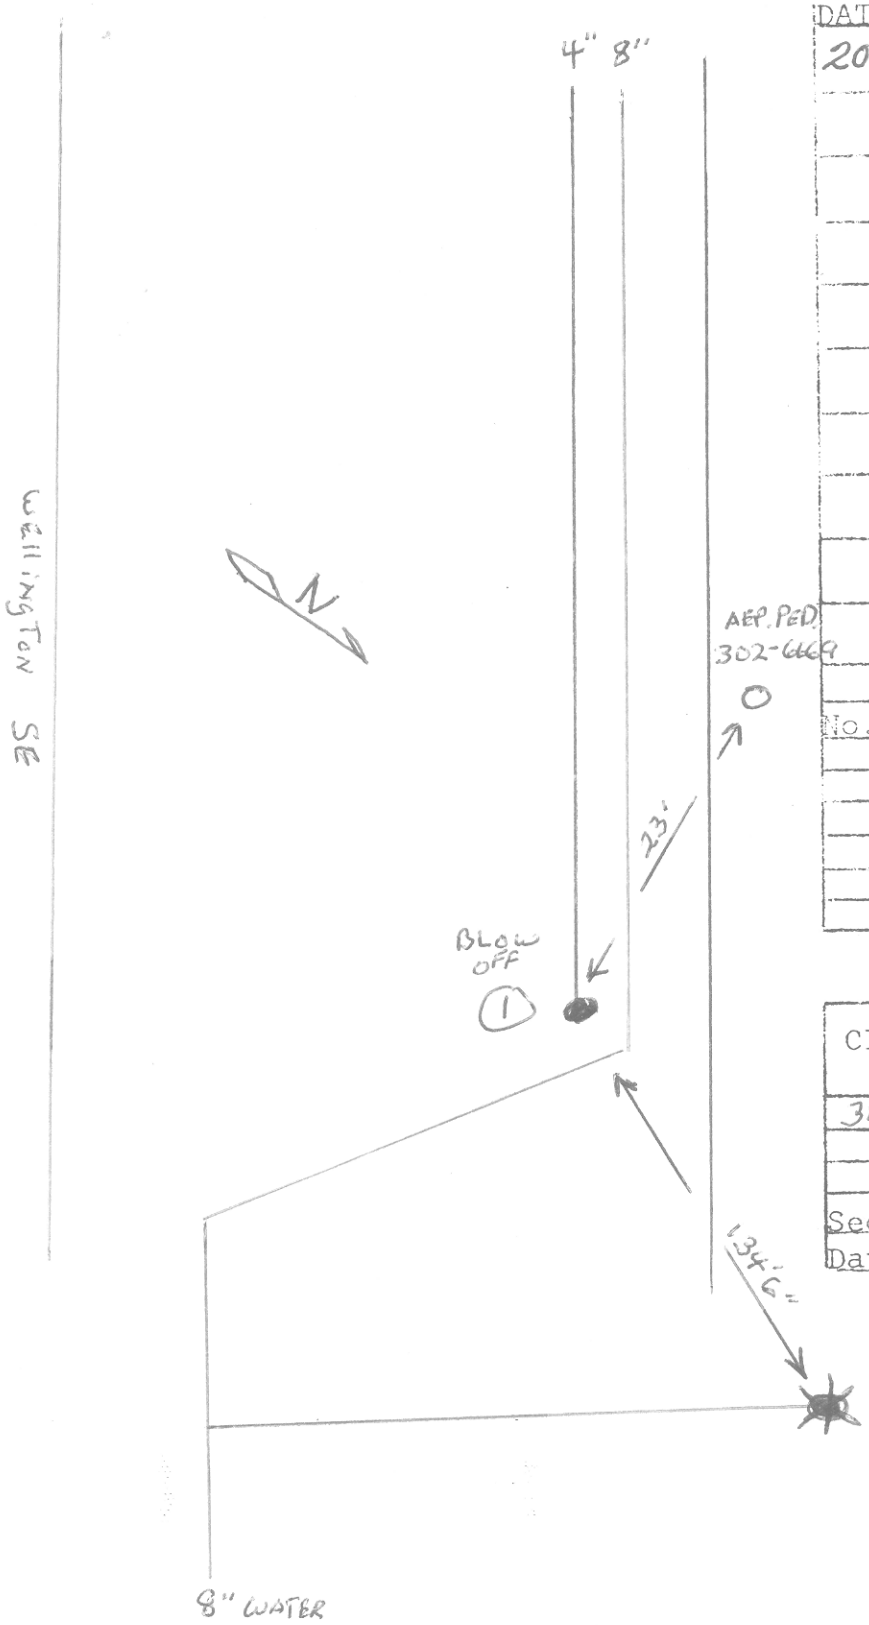

DATE	NO.	SIZE	MAKE	OPEN	TURNS
2003	1	2"	MISC BO	L	7

P. L. Measurements

No.	Distance	Direction

CITY OF ROANOKE - WATER DEPT.
VALVE DIAGRAM

3400 WELLINGTON SE

Sec. Map

Date Page No.