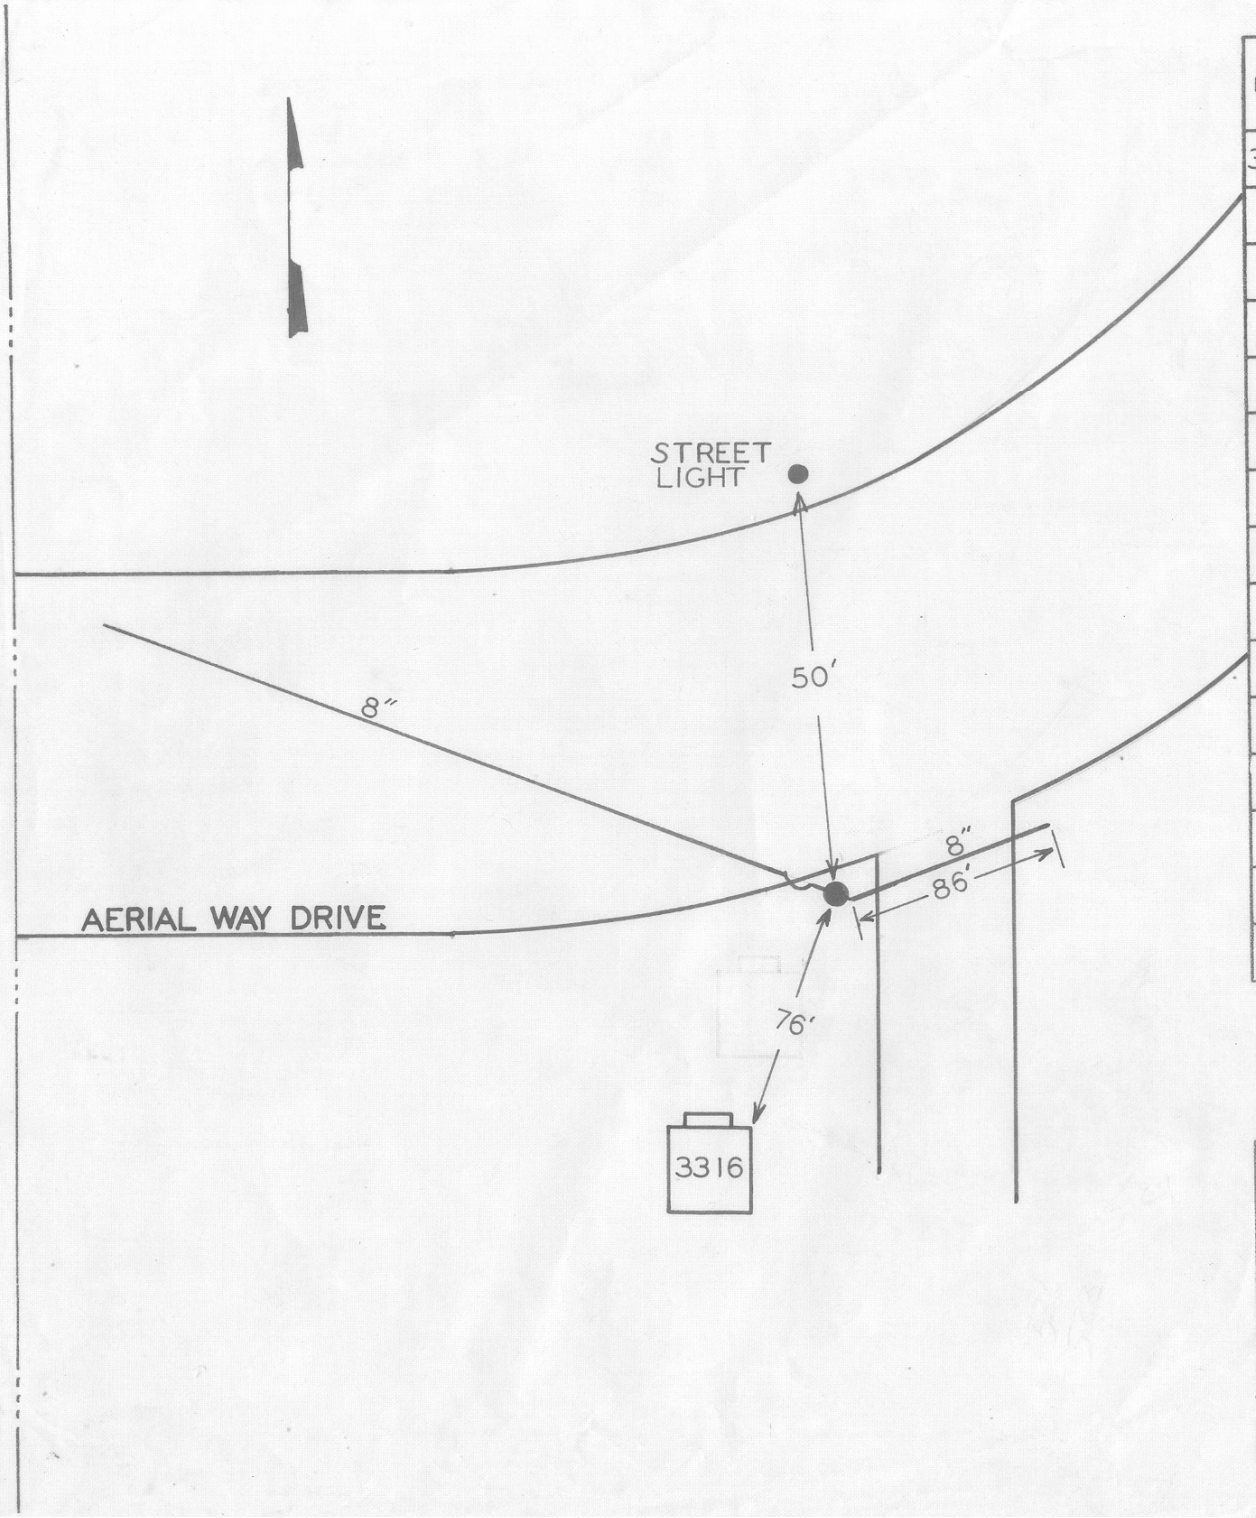

DATE	NO.	SIZE	MAKE	OPEN	TURNS
3-68	1	8"	MUELLER	R	

CITY OF ROANOKE — WATER DEPT.

VALVE DIAGRAM

3316 AERIAL WAY DRIVE S.W.

SEC. MAP 521

DATE PAGE NO.

You created this PDF from an application that is not licensed to print to novaPDF printer (http://www.novapdf.com)