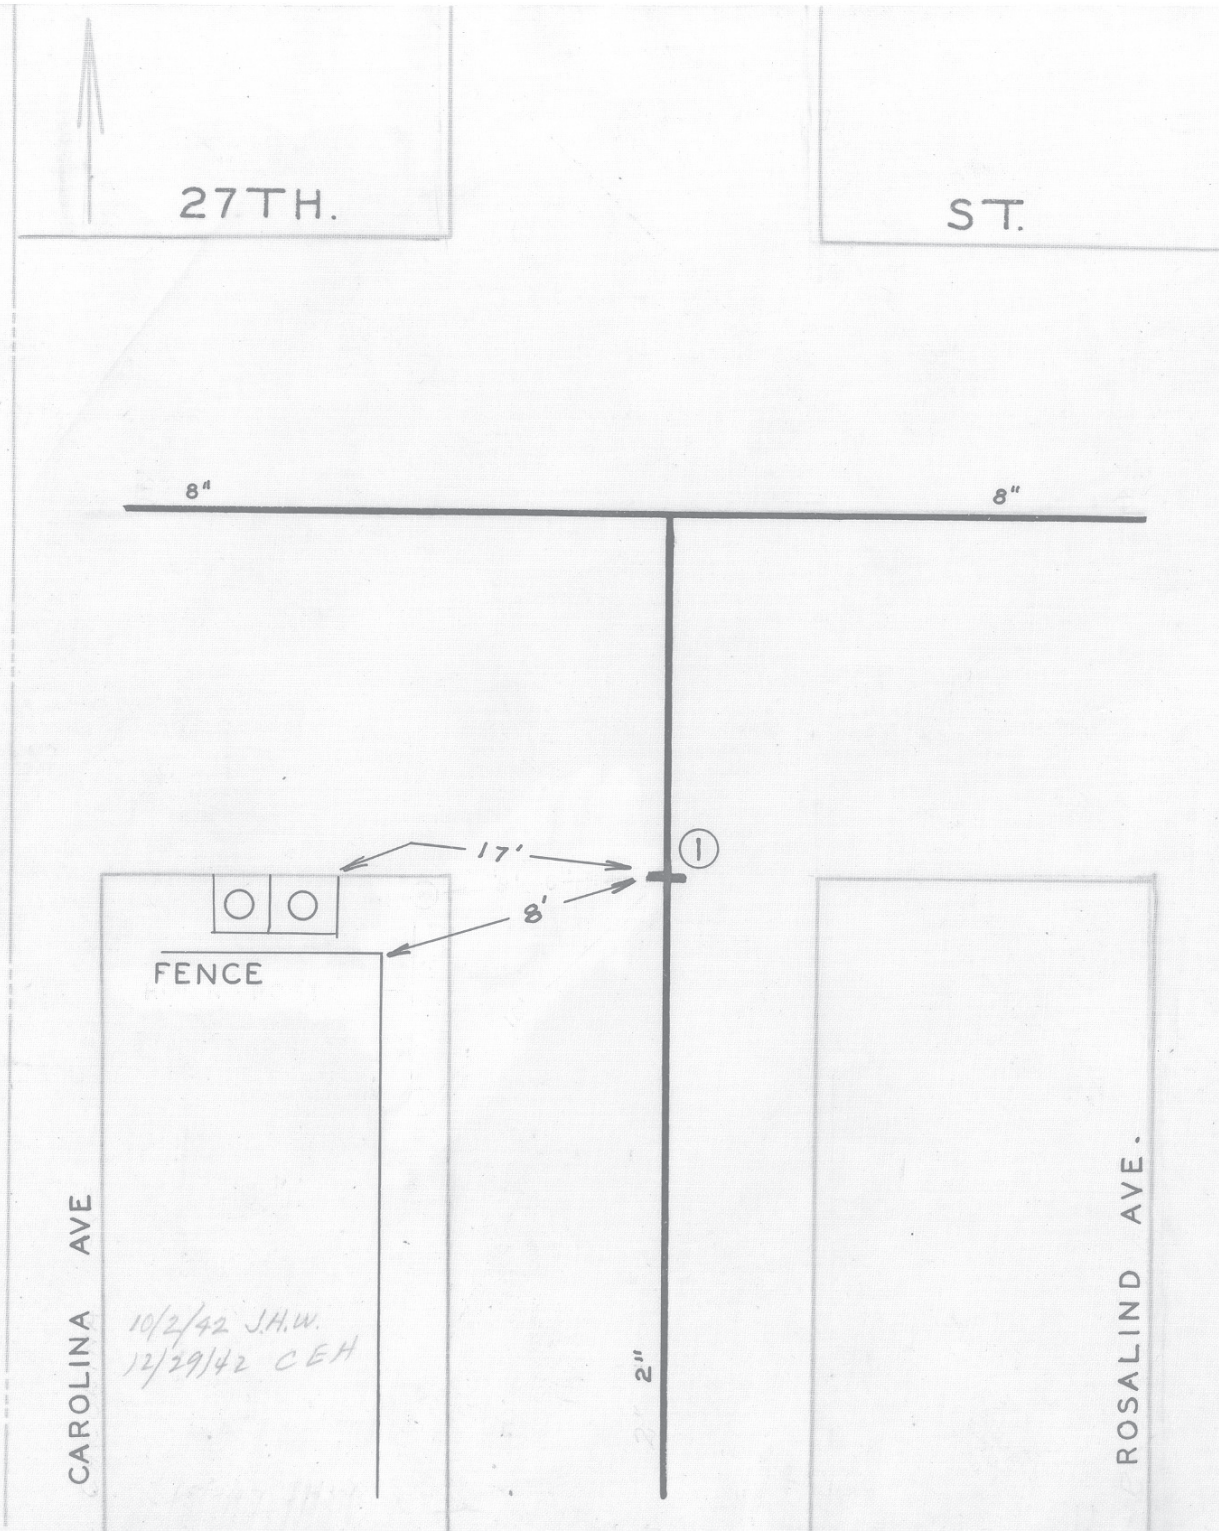

DATE	NO.	SIZE	MAKE	OPEN	TURNS
1939	1	2"		R	7
	1	0	SPL		

CITY OF ROANOKE—WATER DEP'T

VALVE DIAGRAM

ALLEY S. FROM 27TH. ST.
BETWEEN CAROLINA &
ROSALIND AVE. S. W.

SEC. MAP 106

DATE PAGE NO. SW.249