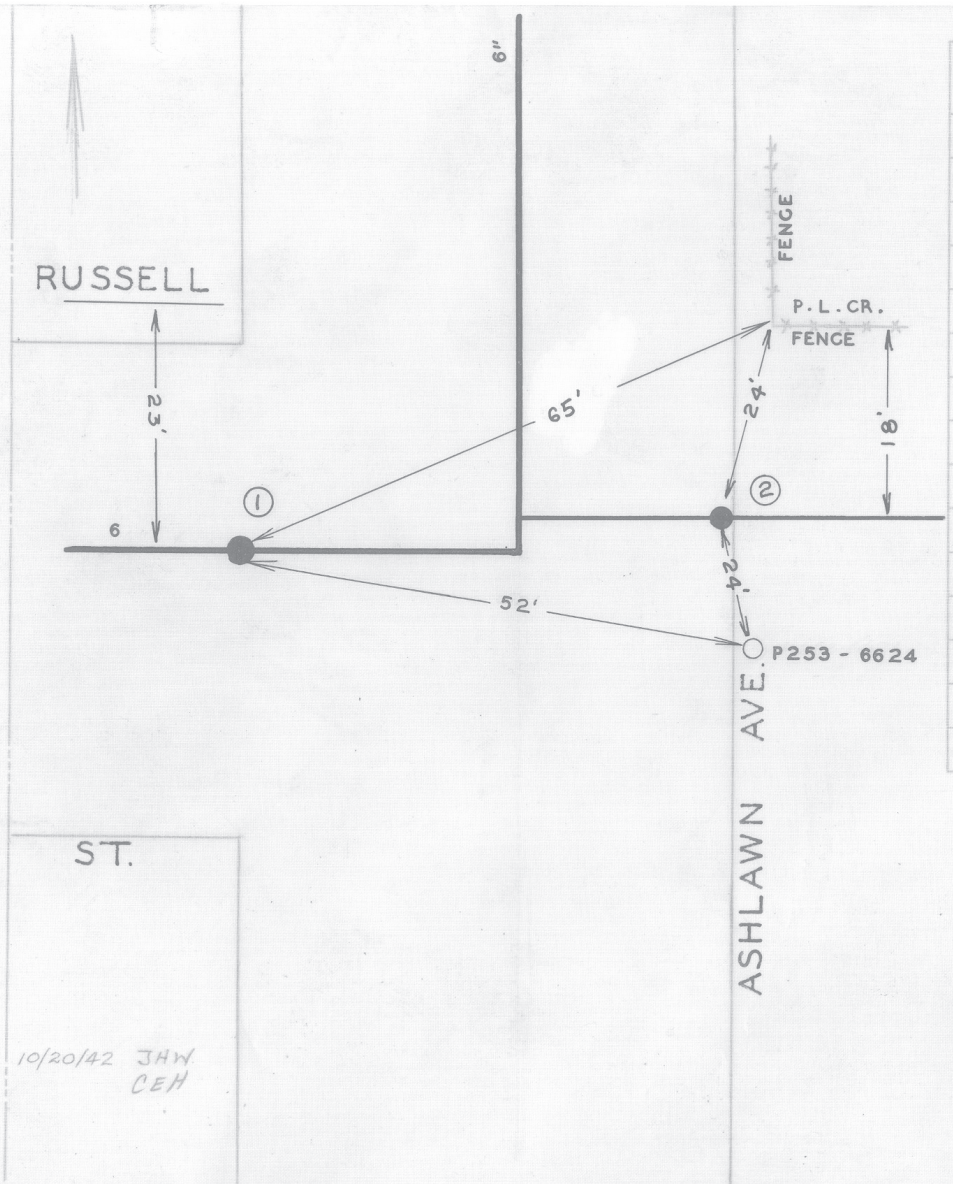

DATE	NO.	SIZE	MAKE	OPEN	TURNS
1892	1	6"		R	20
1954	2	2"	DARLING		
	1	14'-W	WPL		
	2	0	EPL		

10/20/42 JHW
CEH

CITY OF ROANOKE—WATER DEP'T
VALVE DIAGRAM
ASHLAWN AVE. & RUSSELL
ST. S.W.

SEC. MAP 142
DATE
PAGE NO S.W. 400