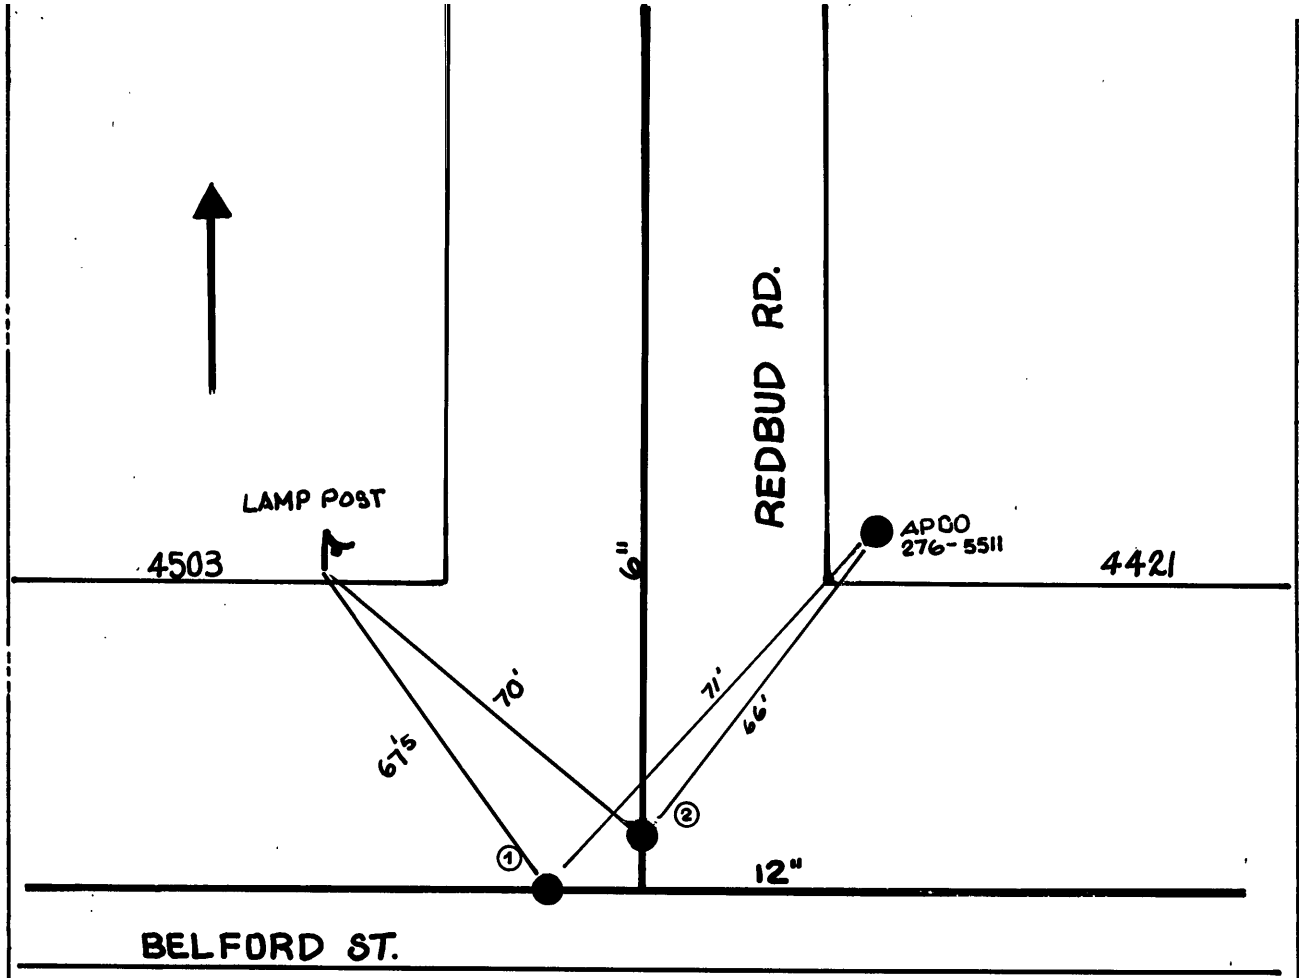

DATE	NO.	SIZE	MAKE	OPEN	TURNS
1979	1	12"	DARLING	R	
1979	2	6"	DARLING	R	

CITY OF ROANOKE—WATER DEP'T

VALVE DIAGRAM

BELFORD ST AND

REDBUD RD SW.

SEC. MAP 511

DATE 7-14-80 PAGE NO.