~~WORKSHEET — 15TH. ST.~~

DATE	NO.	SIZE	MAKE	OPEN	TURNS
1-85	1	8	MUELLER	R	27

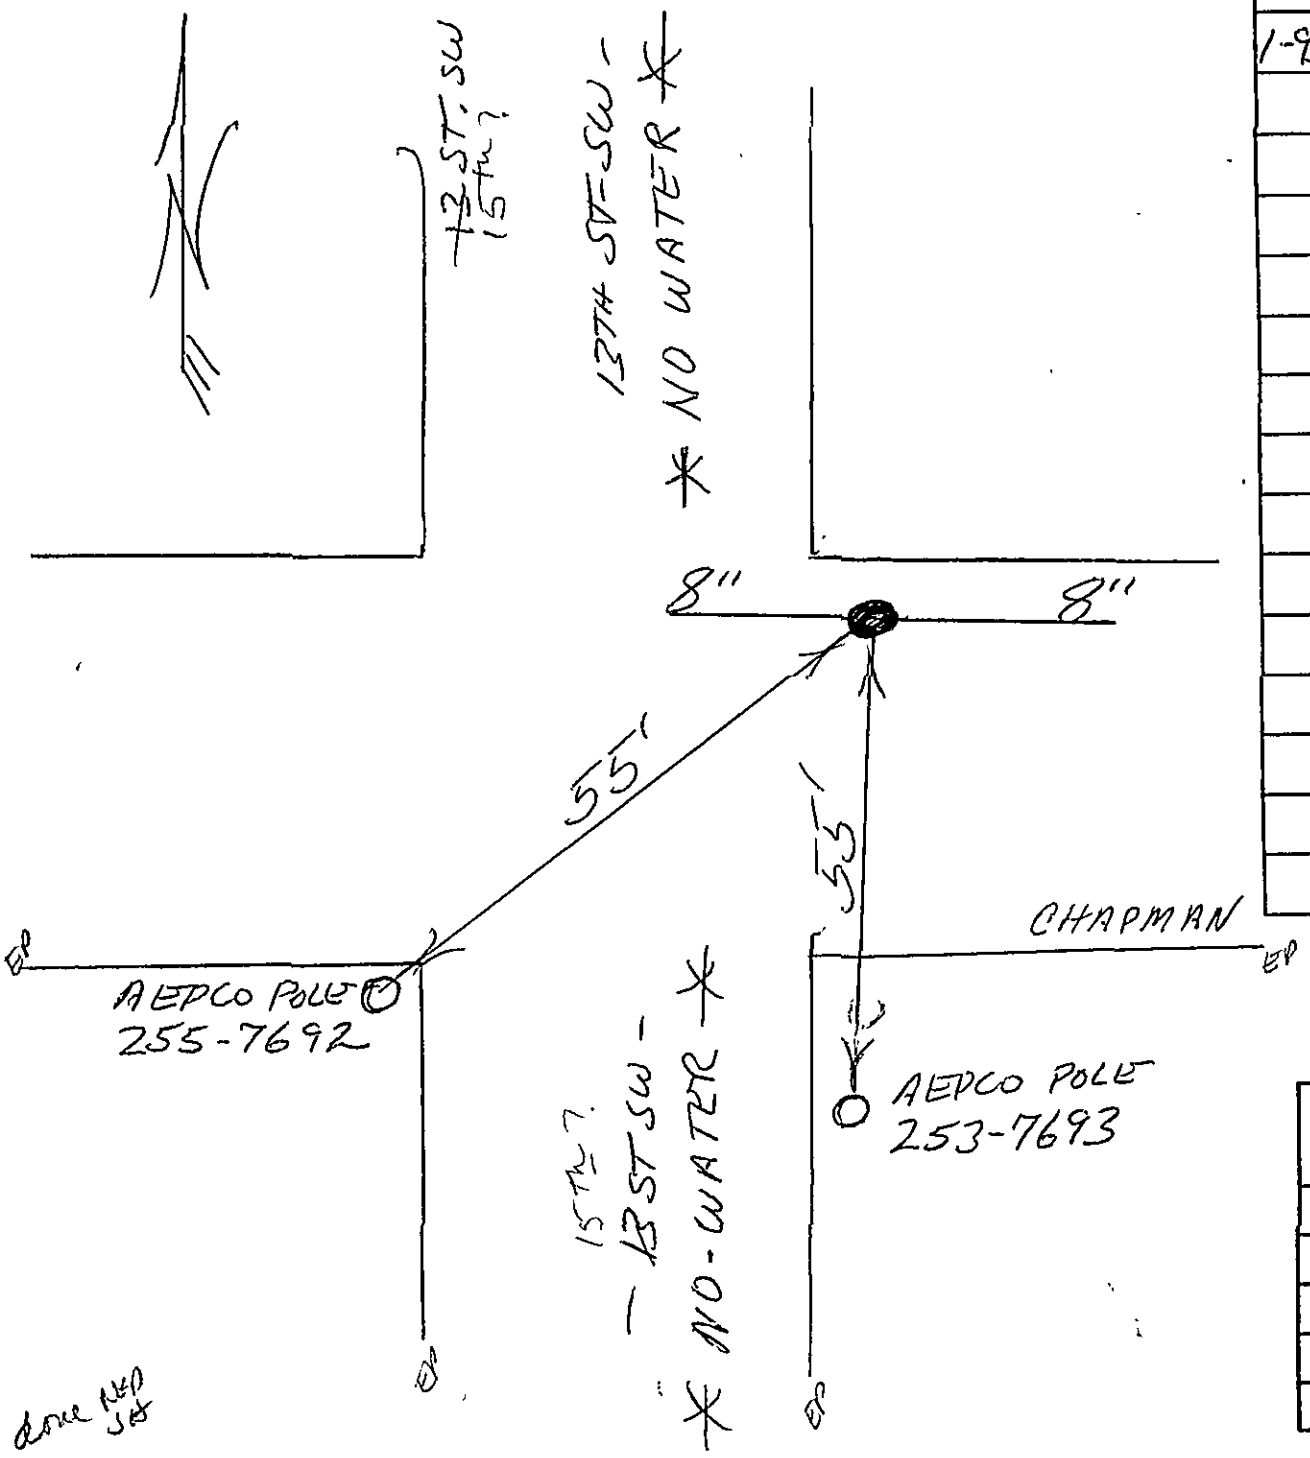

CITY OF ROANOKE—WATER DEP'T

VALVE DIAGRAM

CHAPMAN AVE
& 15TH ST SW

SEC. MAP 121

DATE PAGE NO.