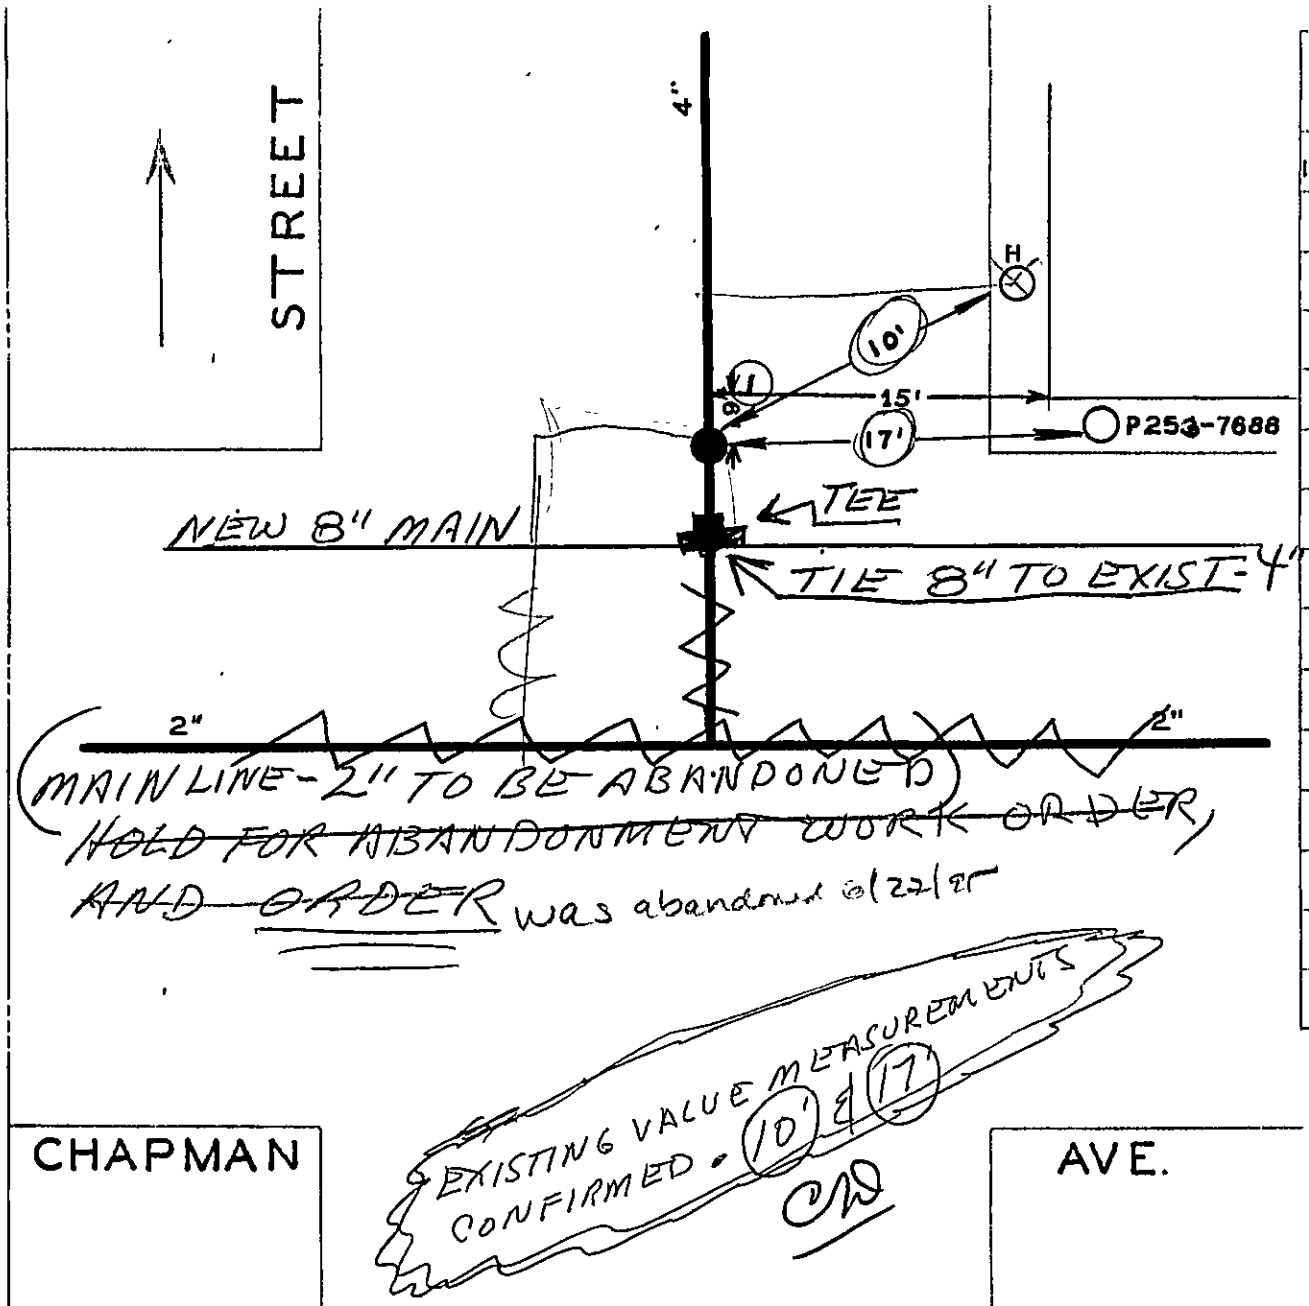

DATE	NO.	SIZE	MAKE	OPEN	TURNS
1906	1	4"		R	8 1/2
	1	6'-S	NPL		

CITY OF ROANOKE—WATER DEP'T

VALVE DIAGRAM

CHAPMAN AVE. & 16TH. ST. S. W.

SEC. MAP 121

DATE

PAGE NO S.W.187