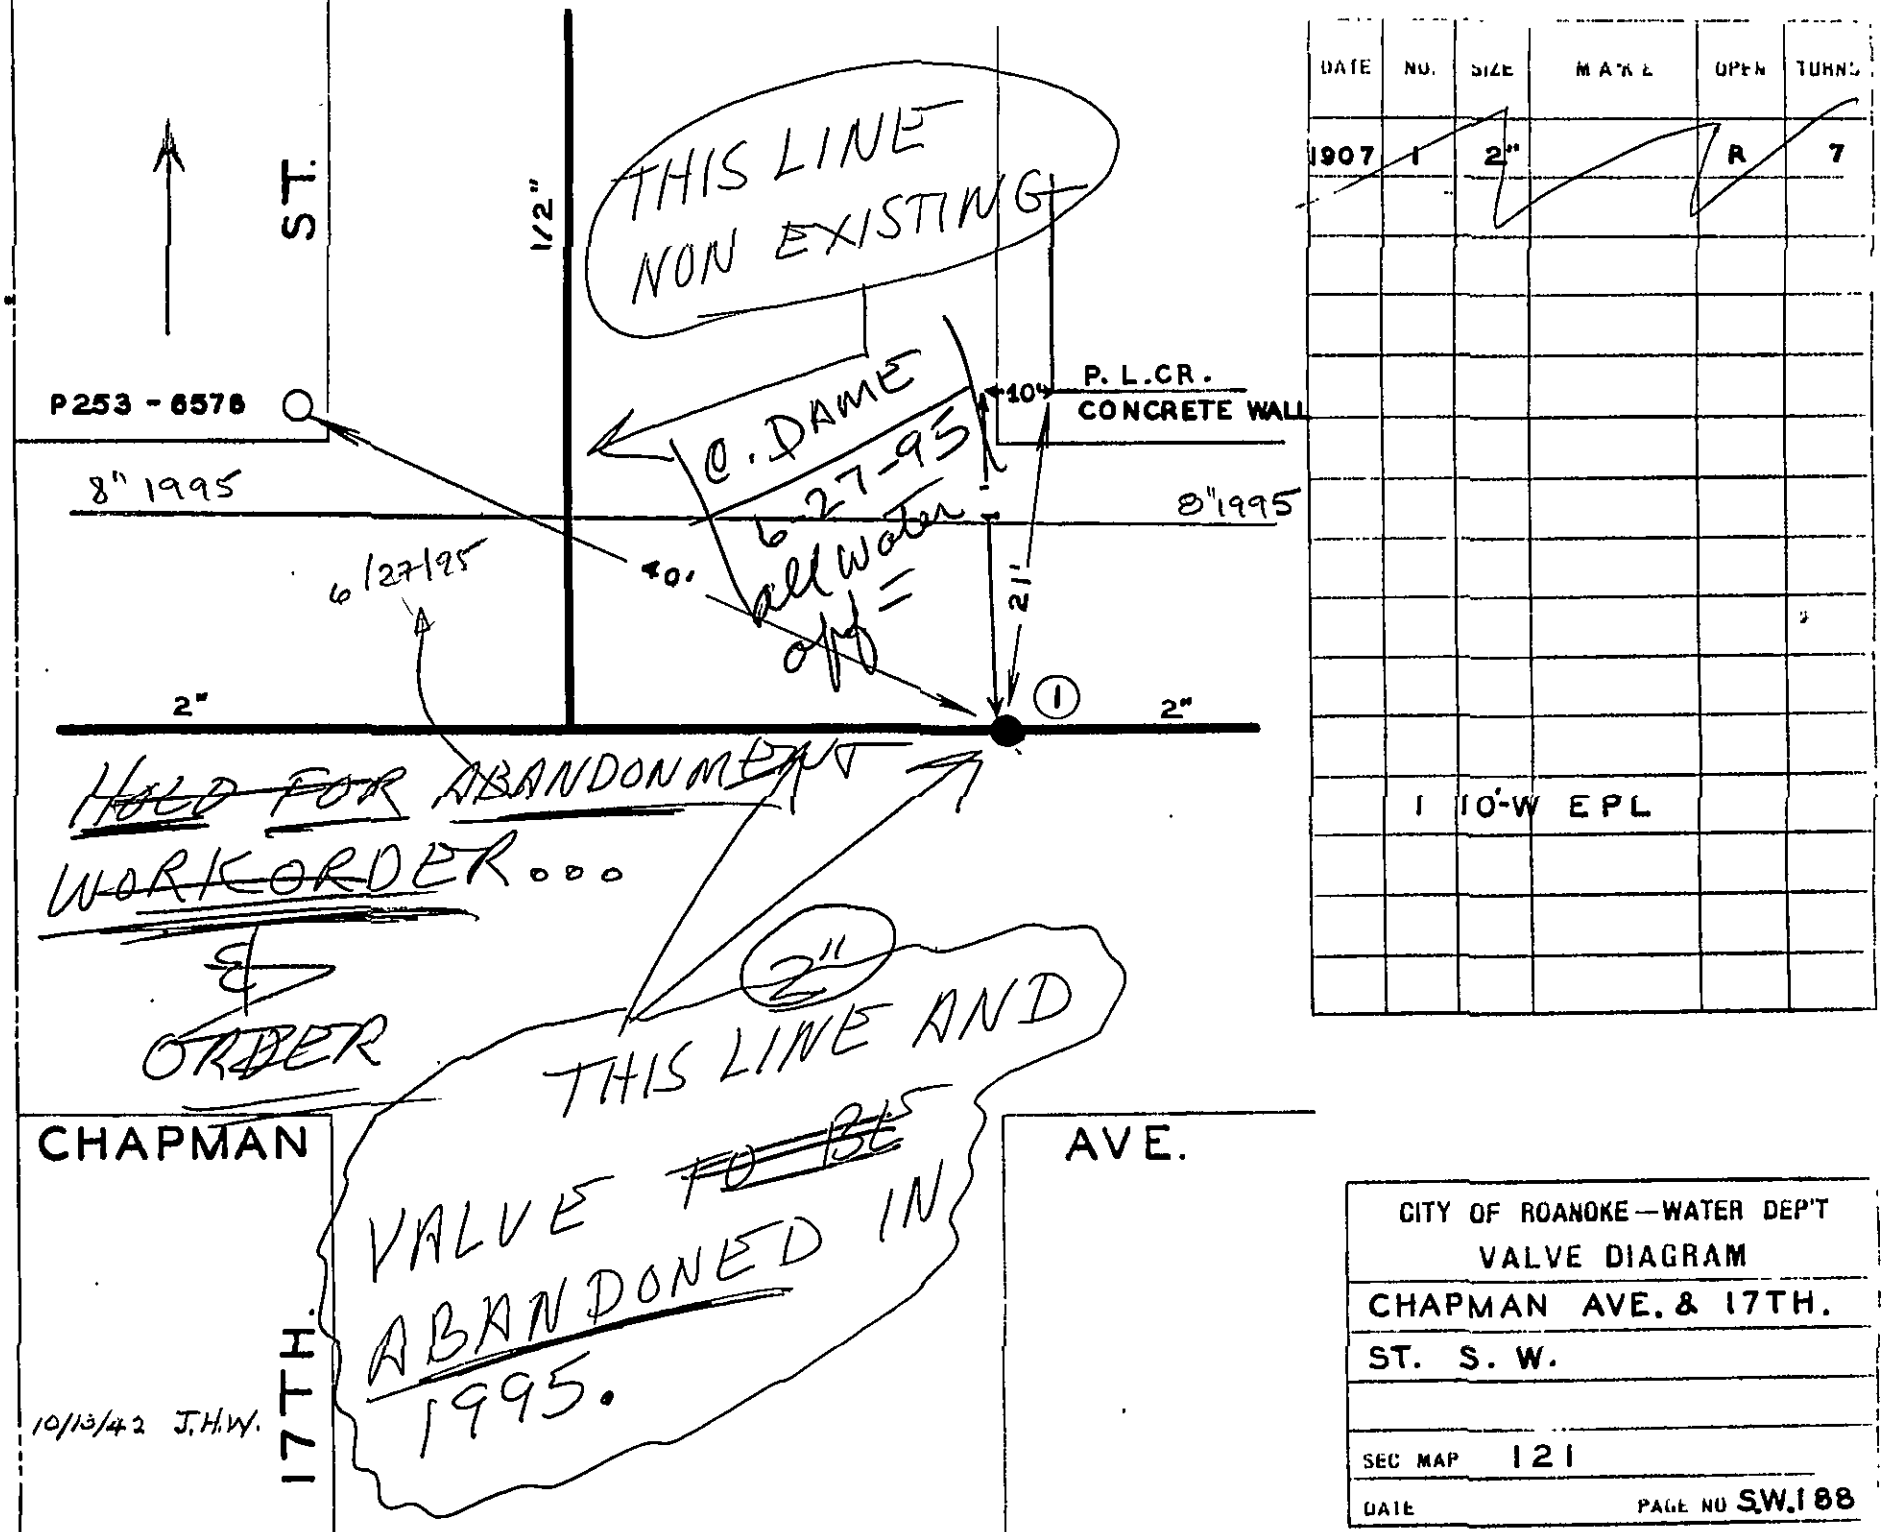


| DATE | NO. | SIZE | MAKE | OPEN | TURNS |
|---|---|---|---|---|---|
| 1907 | 1 | 2" | | R | 7 |
| | | | | | |
| | | | | | |
| | 1 | 10'-W | EPL | | |
| | | | | | |
| | | | | | |
| | | | | | |

CITY OF ROANOKE—WATER DEP'T
VALVE DIAGRAM
CHAPMAN AVE. & 17TH. ST. S. W.

SEC MAP 121

DATE

PAGE NO S.W.188