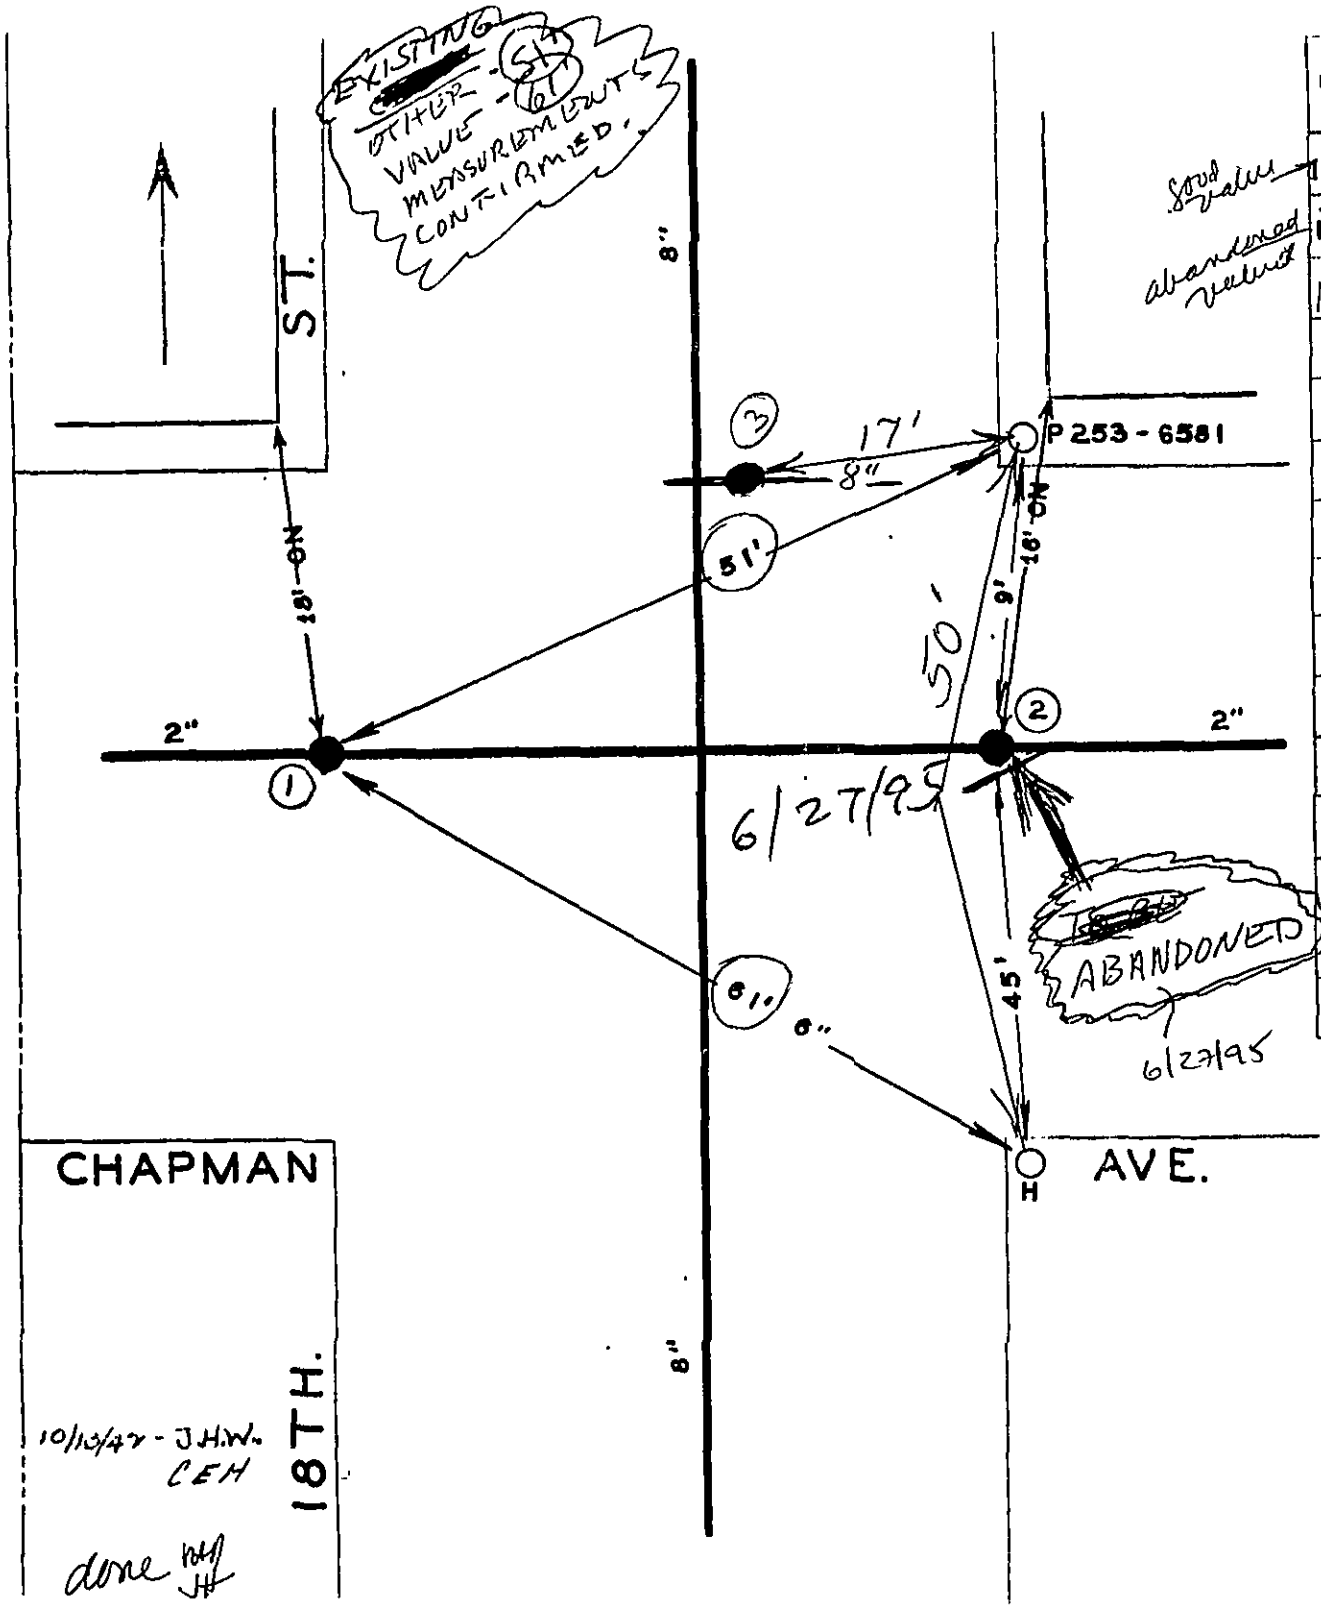

DATE	NO	SIZE	MAKE	OPEN	TURNS
1922	1	2"	Belt Clone	R	7
1922	2	2"	abandoned GOOD	R	7
1995	3	8"	MUELLER	R	27
	1	0	WPL		
	2	0	EPL		

good value

abandoned valved

CITY OF ROANOKE — WATER DEP'T

VALVE DIAGRAM

CHAPMAN AVE. & 18TH.

ST. S.W.

SEC. MAP 121

DATE

PAGE NO S.W.189