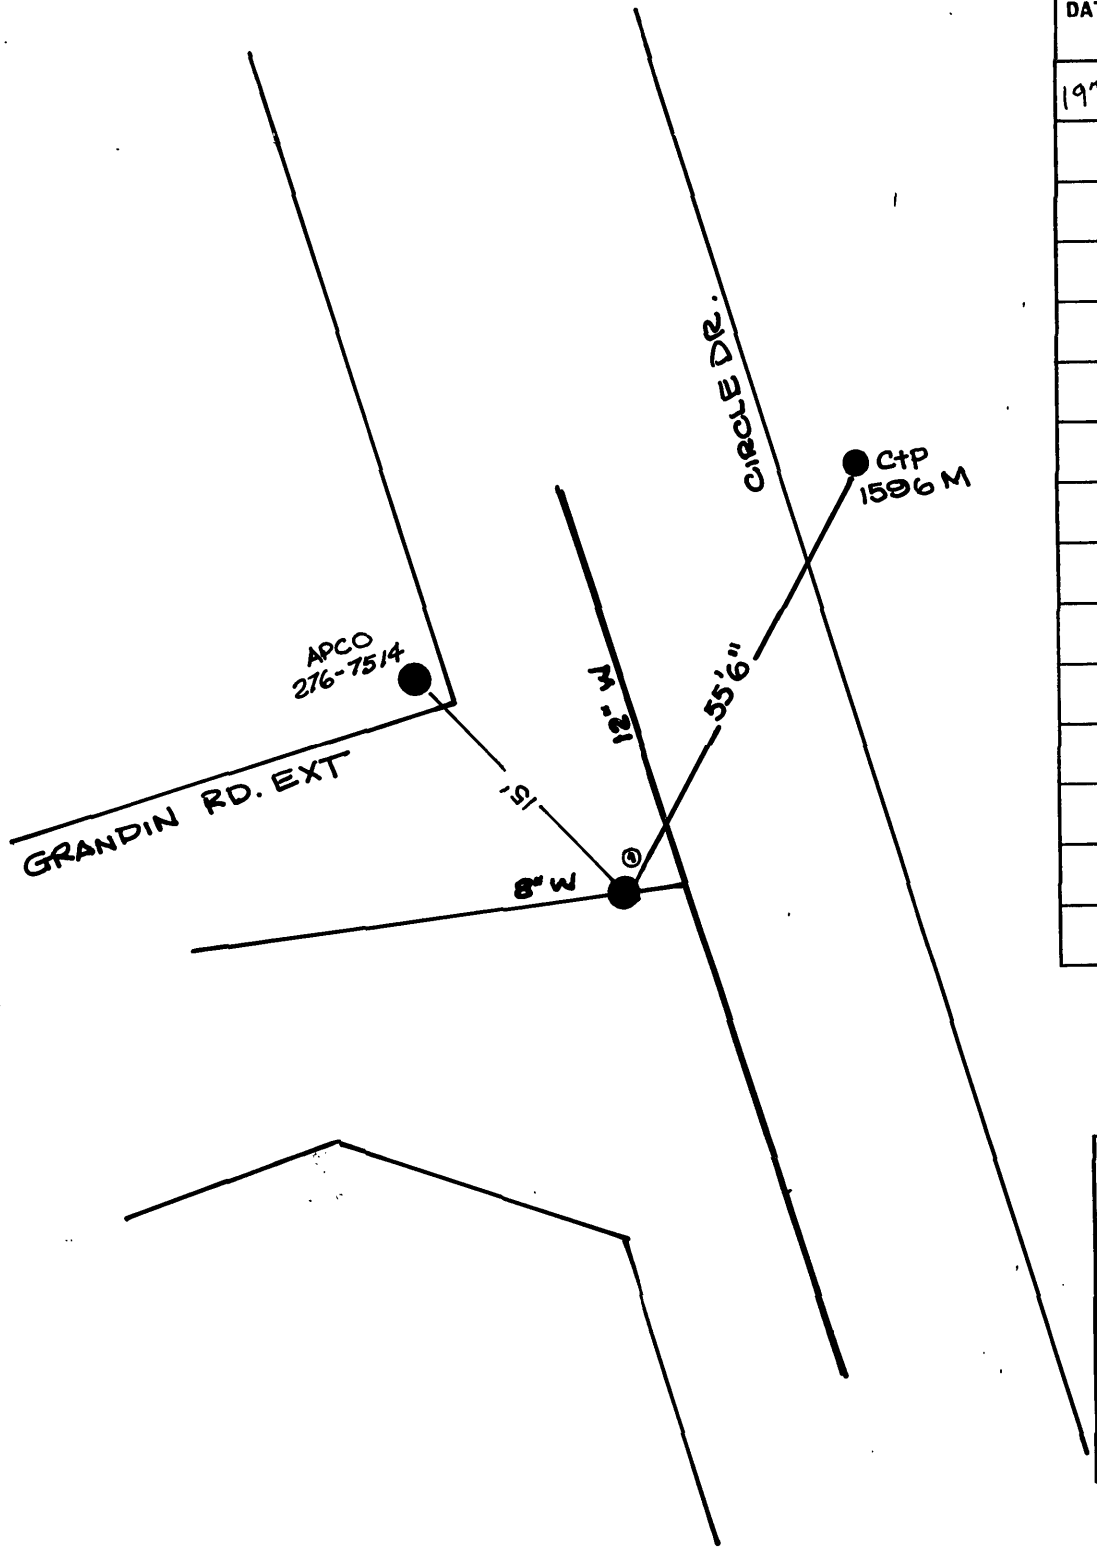

DATE	NO.	SIZE	MAKE	OPEN	TURNS
1979	1	8"	DARLING	R	

CITY OF ROANOKE—WATER DEP'T

VALVE DIAGRAM

CIRCLE DR. AND

GRANDIN RD. EXT. SW

SEC. MAP 501

DATE 12-16-80 PAGE NO.